


Addison Rd

Valve outlay Addison Water Metering Sta.

Addison + Dallas Connection

1

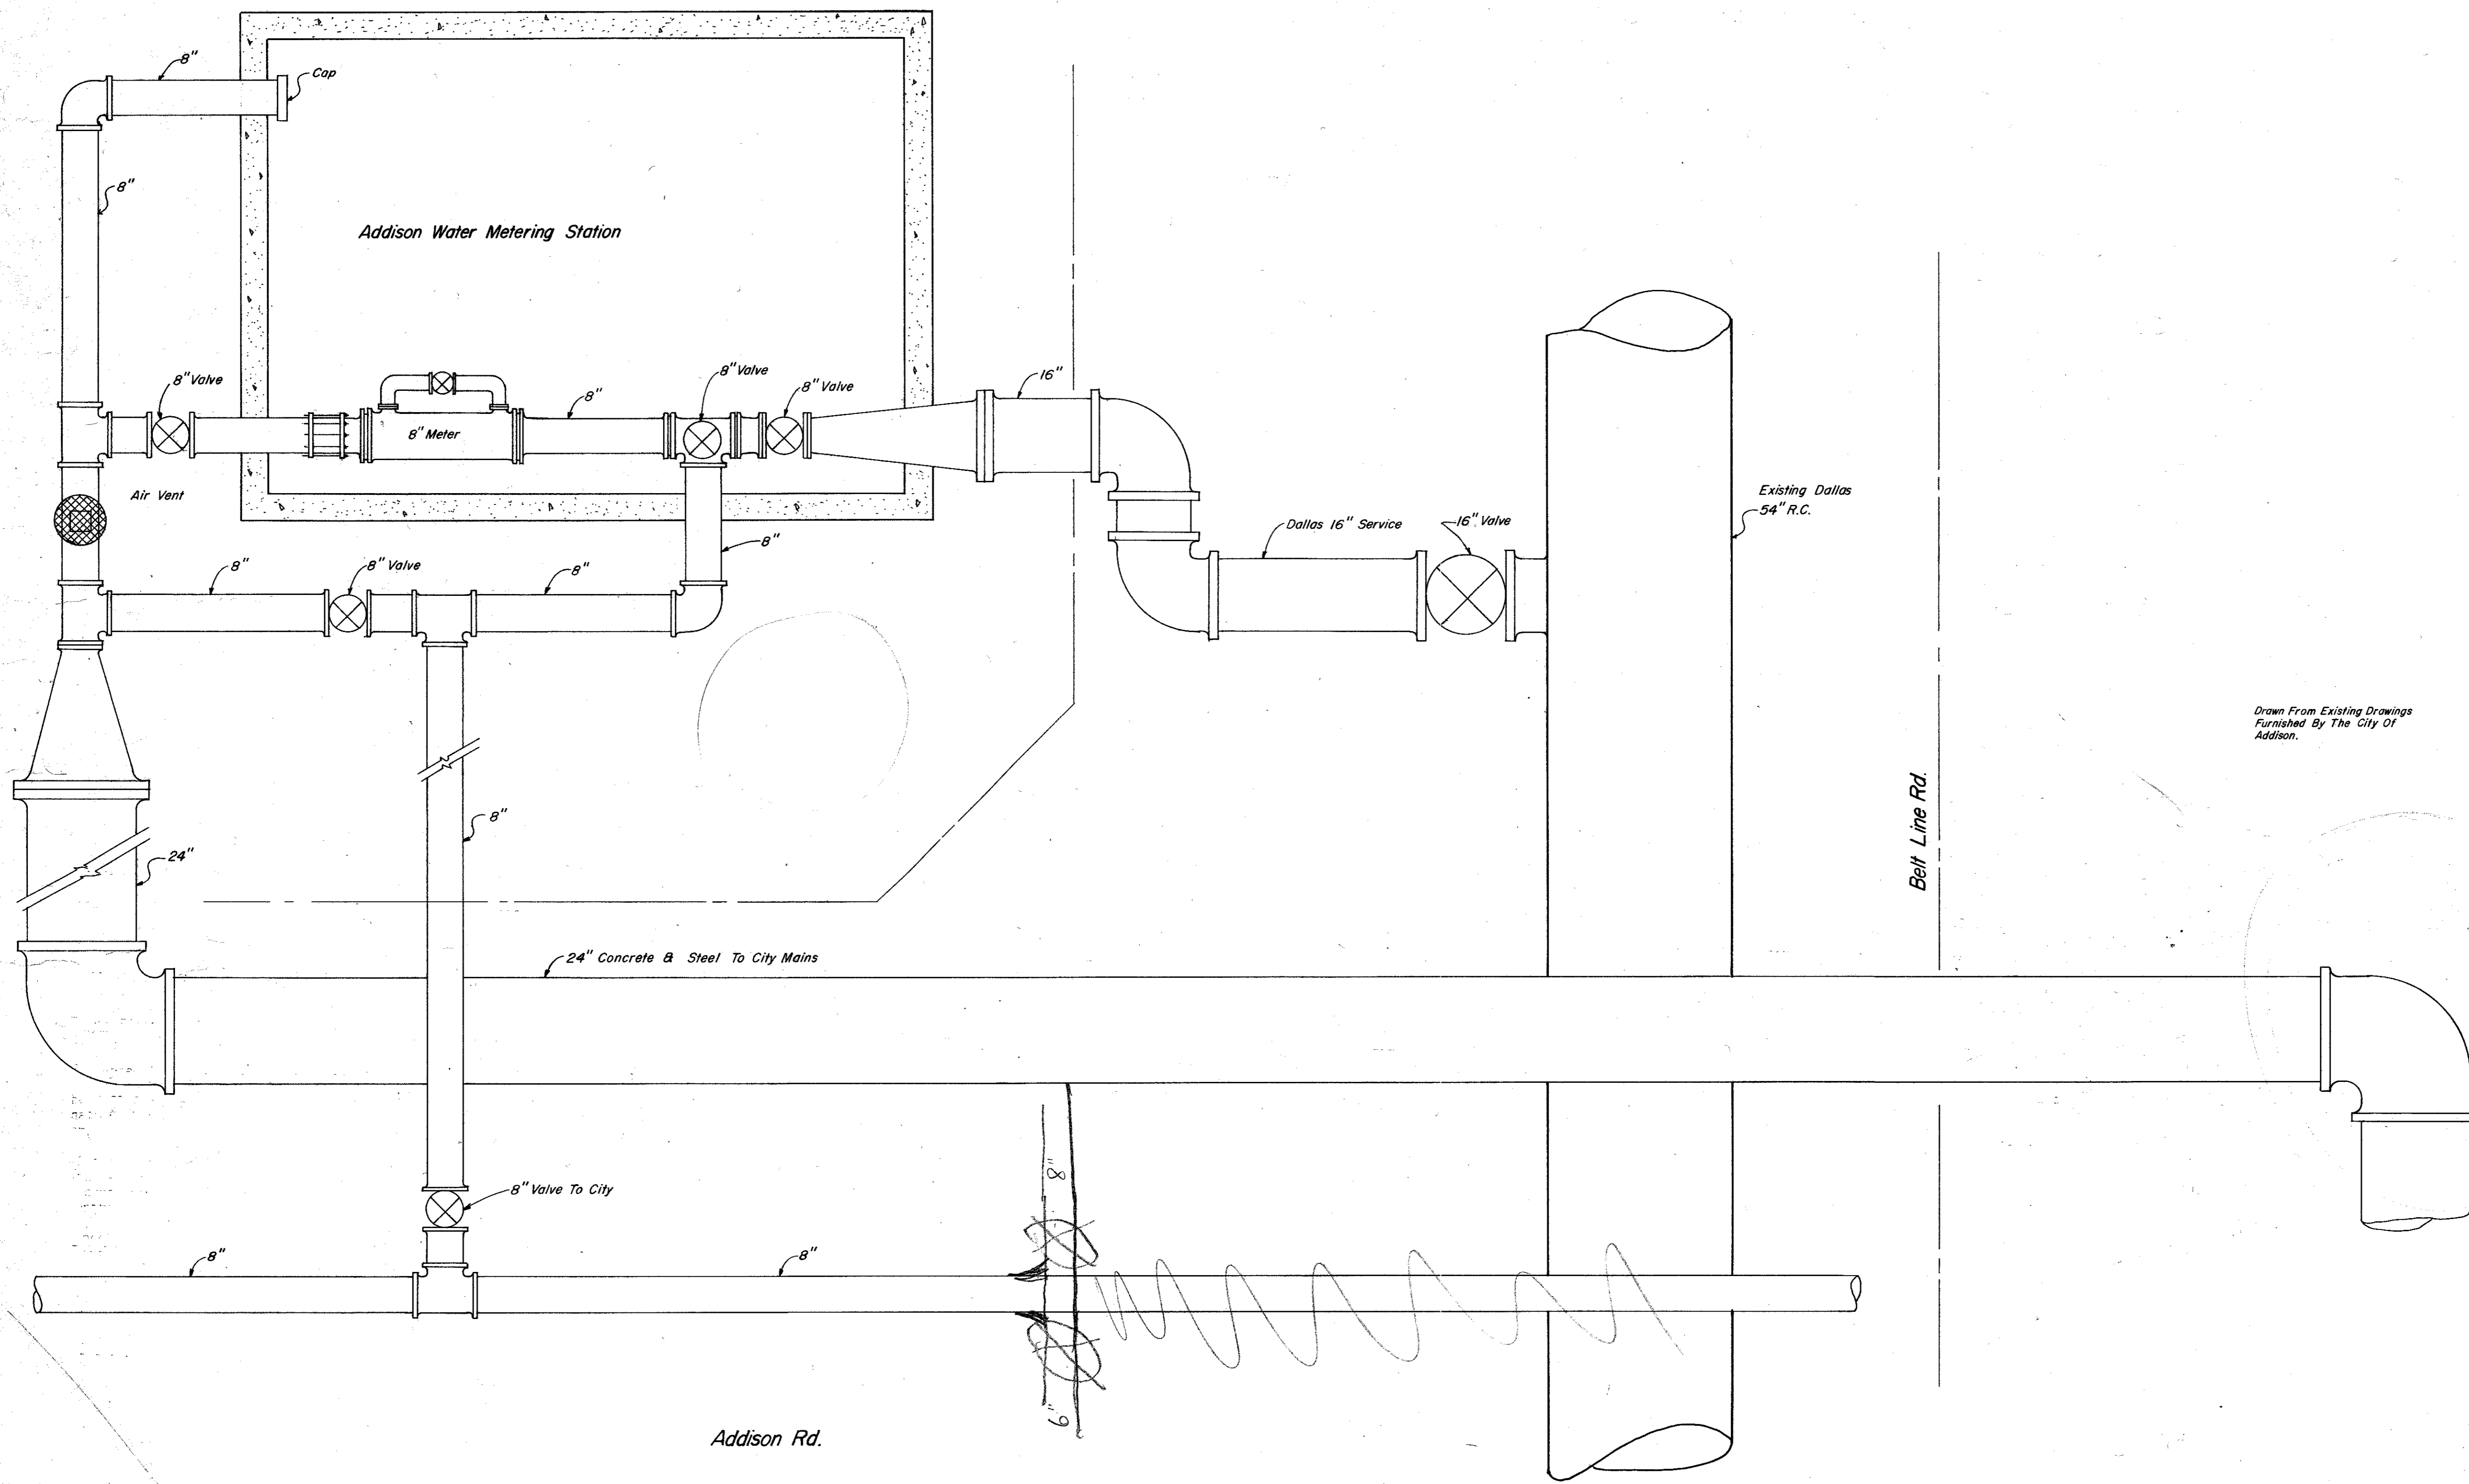

Drawn From Existing Drawings
Furnished By The City Of
Addison.

CITY OF ADDISON DALLAS COUNTY, TEXAS	
WATER IMPROVEMENTS	
VALVE OUTLAY ADDISON WATER METERING STATION	
GINN INC. CONSULTING ENGINEERS DALLAS, TEXAS	
DESIGNED BY: +	SCALE: NONE
DRAWN BY: S.M.M.	DATE: 8/8/79