


BENCHMARK:
12" CUT ON STORM SEWER
INLET ON SOUTH SIDE OF
BELTLINE ROAD 70' WEST
OF COMMERCIAL DRIVE.
ELEV. = 580.56

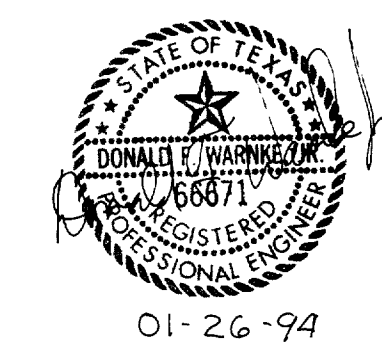

01-26-94

SANITARY SEWER PROFILES						
COMP. U.S.A.						
ADDISON TOWN CENTER						
CITY OF ADDISON, TEXAS						
LAWRENCE A. CATES & ASSOC. CONSULTING ENGINEERS DALLAS, TEXAS						
DESIGN	DRAWN	DATE	SCALE	NOTES	FILE	NO.
LAC	LAC	01/11/94	H:1"=40' V:1"=6'	D.P.	93059	C-12

AS BUILT
I CERTIFY THAT THESE PROFILES WERE CONSTRUCTED IN ACCORDANCE WITH THE CITY OF ADDISON SPECIFICATIONS AND ALL PLANS, NOTES AND CONDITIONS.

REV 5/12/94 LINE B 8\"/>

