



C:\DWG5\9404\DRNGMAP Mod May 18 11:10:30 1994

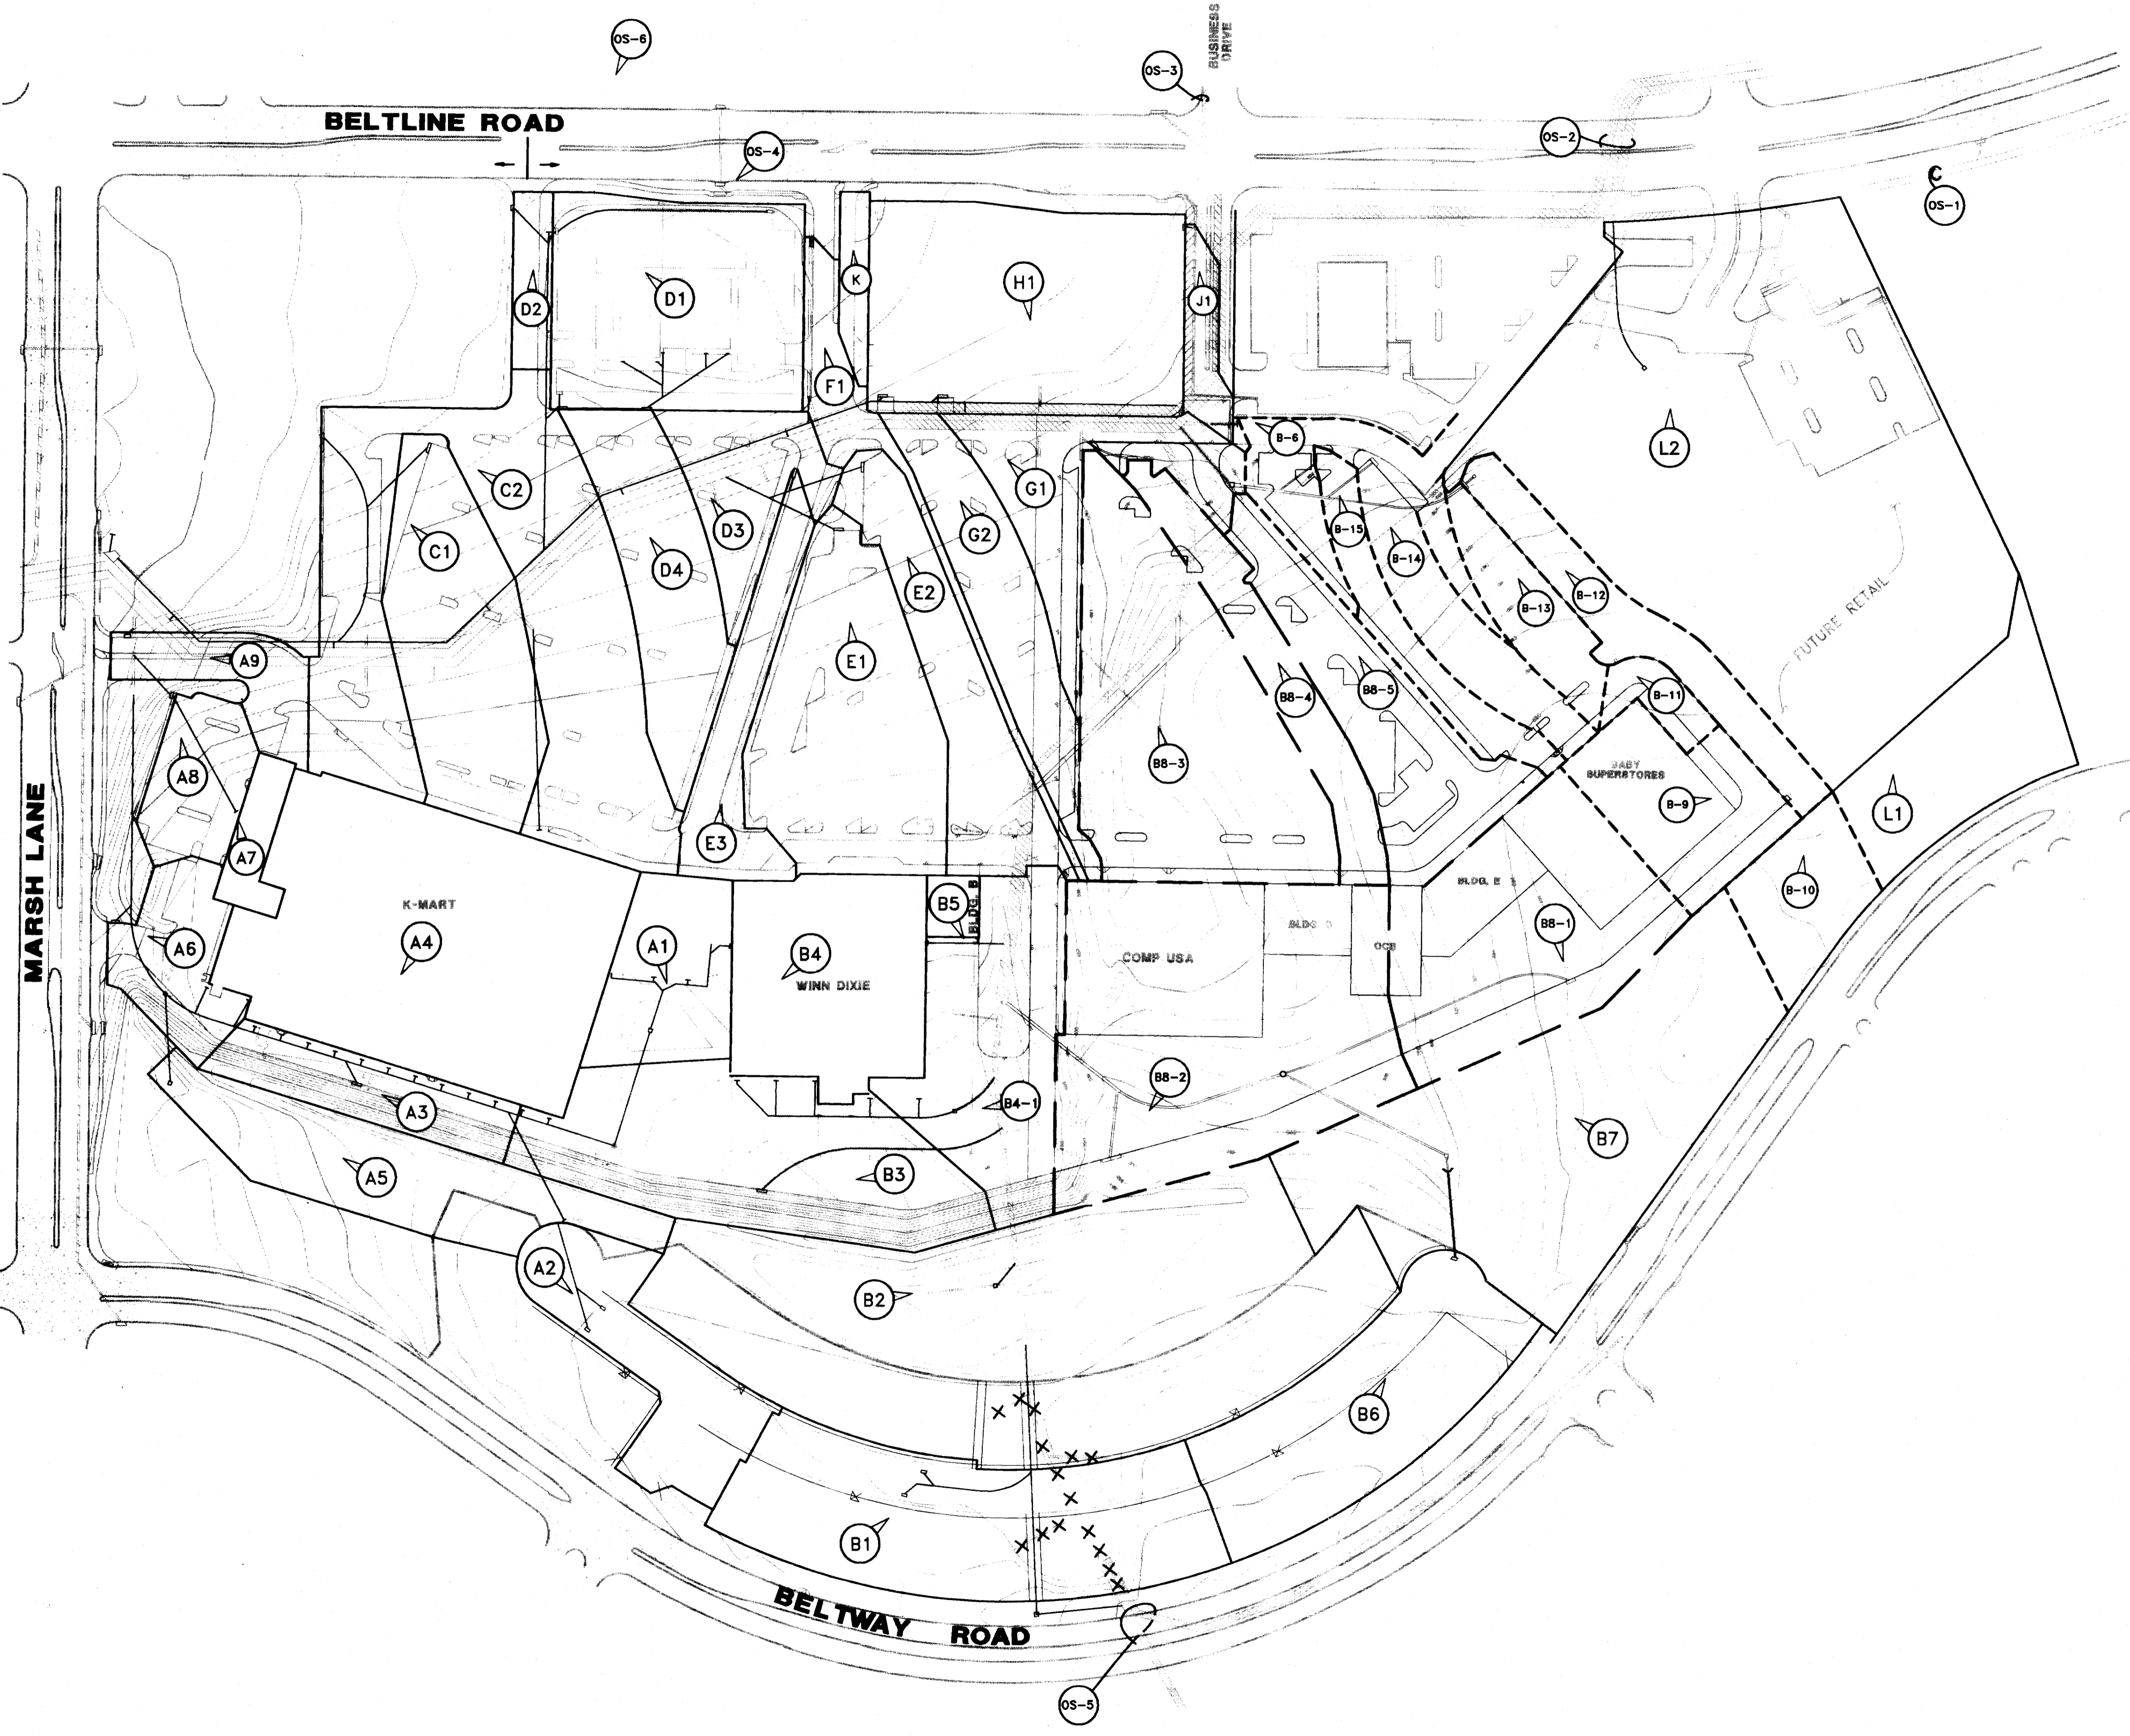

DRAINAGE SUMMARY


AREA	ACRES	C	1100	Q100	REMARKS
A1	0.88	0.9	8.74	5.35	INC. ROOF DRAIN-BLDG. A
A2	0.87	0.5	8.74	3.80	FROM RES. SUBD.
A3	0.56	0.9	8.74	4.40	TO 10' C.I.
A4	2.69	0.9	8.74	21.13	KMART ROOF DRAINAGE
A5	1.18	0.4	7.70	3.60	PARK AREA
A6	0.49	0.9	8.74	3.85	TO 10' C.I.
A7	0.15	0.9	8.74	1.61	GARDEN SHOP DRAINAGE
A8	0.44	0.9	8.74	3.46	TO 6' C.I.
A9	0.36	0.9	8.74	2.83	TO 6' C.I.
B1	1.98	0.5	8.74	8.56	FROM SUBD. TO 54"
B2	4.45	0.45	7.70	15.40	PARK AREA
B3	1.46	0.9	8.74	11.48	TO 14' C.I.
B4	1.24	0.9	8.74	9.75	WINN-DIXIE ROOF DRAIN
B4-1	1.84	0.9	8.74	14.75	6" GRATE INLET
B5	0.10	0.9	8.74	0.79	BLDG. B ROOF DRAIN
B6	1.44	0.5	8.74	6.29	FROM SUBD. (6' CI)
B7	2.75	0.4	7.70	8.16	FUTURE PARK TO 3x3 DROP
B8-1	1.51	0.9	8.74	11.88	TO 10' C.I.
B8-2	2.81	0.9	8.74	22.10	TO 2X10' CI
B8-3	2.08	0.9	8.74	16.36	TO 14' CI
B8-4	0.83	0.9	8.74	4.97	TO 6' CI
B8-5	1.08	0.9	8.74	8.50	TO 10' CI
B8-6	0.57	0.9	8.74	4.50	TO EX. 10' C.I.
B-9	0.73	0.90	8.74	5.7	TO 6" FLUME
B-10	0.48	0.40	7.70	1.5	TO PROP. SWALE (PARK)
B-11	0.21	0.90	8.74	1.7	TO 5" FLUME
B-12	0.57	0.90	8.74	4.5	PROP. SWALE TO 3'x3' D.I.
B-13	0.44	0.90	8.74	3.5	TO 10' C.I.
B-14	0.57	0.90	8.74	4.5	TO 10' C.I.
B-15	0.46	0.90	8.74	3.6	TO 10' C.I.
C1	1.22	0.9	8.74	9.60	TO 10' C.I.
C2	2.64	0.9	8.74	20.80	TO 20' C.I.
D1	1.66	0.9	8.74	13.06	FUTURE LOT 1, BLK D
D2	0.21	0.9	8.74	1.57	TO 6' C.I.
D3	0.61	0.9	8.74	4.80	TO 10' C.I.
D4	0.93	0.9	8.74	7.31	TO 10' C.I.
E1	1.58	0.9	8.74	12.43	TO 10' C.I.
E2	0.88	0.9	8.74	6.92	TO 10' C.I.
E3	0.60	0.9	8.74	4.72	TO 10' C.I.
F1	0.53	0.9	8.74	4.17	TO 6' C.I.
G1	0.55	0.9	8.74	4.33	TO 10' C.I.
G2	0.85	0.9	8.74	6.89	TO 10' C.I.
H1	2.00	0.9	8.74	15.73	FUTURE LOT 2
J1	0.18	0.9	8.74	1.42	TO EXIST. INLET
K	0.12	0.9	8.74	0.94	TO BELT LINE ROAD
L1	0.90	0.45	7.70	3.12	FUTURE PARK
L2	5.56	0.9	8.74	43.74	FUTURE RETAIL
OS-1	175.00	0.50	6.8	714	FROM 96" RCP
OS-2	414.00	0.80	4.8	1590	FROM AREA N. OF BELT LINE
OS-3	16.73	0.90	7.7	116	54"(BUSINESS DR.)
OS-4	01.14	0.90	8.7	9	FROM BELT LINE RD.
OS-5	62.00	0.52	7.6	246	4" GRATE INLET
OS-6	17.60	0.90	7.7	122	54" TO LOW PT. OF BELTLINE

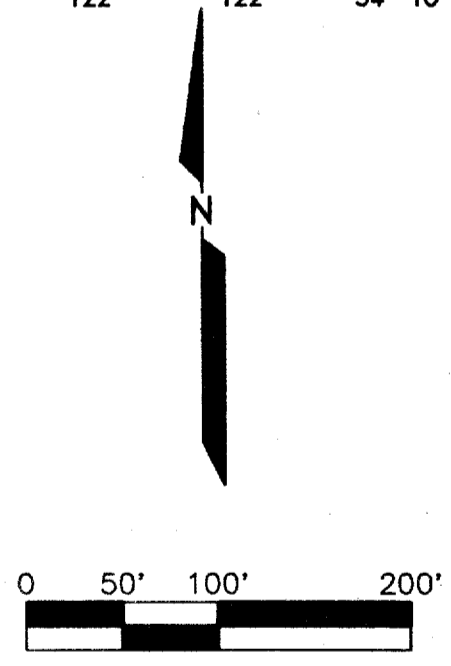

AS-BUILTS
 I CERTIFY THIS PROJECT WAS CONSTRUCTED IN GENERAL CONFORMANCE WITH THESE CONSTRUCTION PLANS AND WILL FUNCTION AS DESIGNED.



THE SEAL APPEARING ON THIS DOCUMENT WAS AUTHORIZED BY DONALD F. WARNKE JR., P.E. 66671 ON 01/21/94

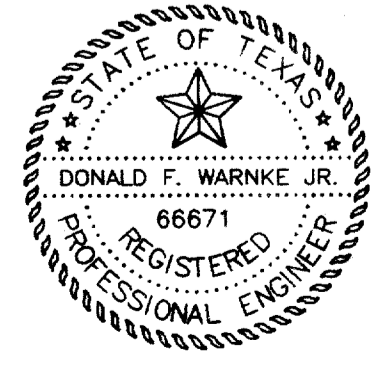

REV	DATE	DESCRIPTION
1	5/12/94	ADDED BABY SUPERSTORES

DRAINAGE AREA MAP
 COMP USA
 ADDISON TOWN CENTER
 TOWN OF ADDISON, TEXAS

LAWRENCE A. CATES & ASSOC. CONSULTING ENGINEERS
 DALLAS, TEXAS

DESIGN	DRAWN	DATE	SCALE	NOTES	FILE	NO.
LAC	LAC		1"=100'	D.P.	94044 DRNGMAP.DWG	C-9