


BENCHMARK:  
 "1" CUT ON STORM SEWER  
 INLET ON SOUTH SIDE OF  
 BELTLINE ROAD 70± WEST  
 OF COMMERCIAL DRIVE.  
 ELEV. = 580.56

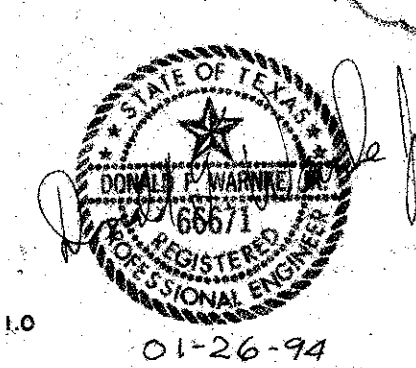

REV. 5/12/94 VOID LN 5.0  
 REV. 02/07/94 ADDED TYPE A M.H. LN SD 1.0

STORM SEWER PROFILES					
COMP. U.S.A.					
ADDISON TOWN CENTER					
CITY OF ADDISON, TEXAS					
LAWRENCE A. CATES & ASSOC. CONSULTING ENGINEERS DALLAS, TEXAS					
DESIGN	DRAWN	DATE	SCALE	NOTES	FILE NO.
LAC	LAC	01/11/94	H:1"=40' V:1"=6'	D.P.	93059 C-10