



AS-BUILTS  
 I CERTIFY THIS PROJECT WAS CONSTRUCTED IN GENERAL CONFORMANCE WITH THESE CONSTRUCTION PLANS AND WILL FUNCTION AS DESIGNED.

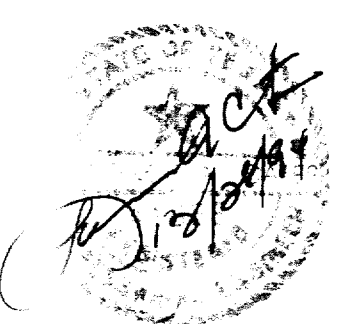

BENCHMARK:  
 □ CUT ON STORM SEWER INLET ON SOUTH SIDE OF BELTLINE ROAD 70± WEST OF COMMERCIAL DRIVE.  
 ELEV. = 580.56

REV. 5/12/94 VOID LN. SD 5.0  
 REV. 02/07/94 ADDED TYPE A M.H. LN. SD 1.0

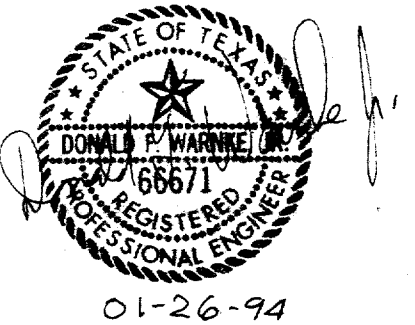

| STORM SEWER PROFILES  |       |          |                       |       |       |      |
|---|-------|----------|-----------------------|-------|-------|------|
| COMP U.S.A.   |       |          |                       |       |       |      |
| ADDISON TOWN CENTER   |       |          |                       |       |       |      |
| CITY OF ADDISON, TEXAS  |       |          |                       |       |       |      |
| LAWRENCE A. CATES & ASSOC. CONSULTING ENGINEERS DALLAS, TEXAS |       |          |                       |       |       |      |
| DESIGN  | DRAWN | DATE     | SCALE                 | NOTES | FILE  | NO.  |
| LAC   | LAC   | 01/11/94 | H: 1"=40'<br>V: 1"=6' | D.P.  | 93059 | C-10 |