


AS-BUILTS

I CERTIFY THIS PROJECT WAS CONSTRUCTED IN GENERAL CONFORMANCE WITH THESE CONSTRUCTION PLANS AND WILL FUNCTION AS DESIGNED.

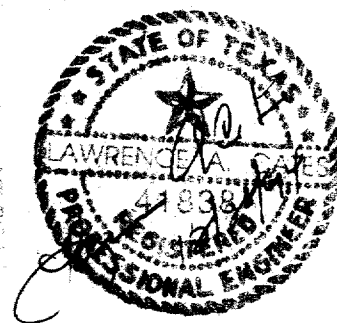


BENCHMARK:

N.W. CORNER OF EXISTING C SOUTH SIDE OF BELT LINE 575' WEST OF THE INTERSECTION OF BELT LINE ROAD AND BUSINESS AVENUE. ELEV. 573.0

BENCHMARK:

" " CUT ON STORM SEWER INLET ON SOUTH SIDE OF BELT LINE ROAD 70' WEST OF COMMERCIAL DRIVE. ELEV. 580.56'

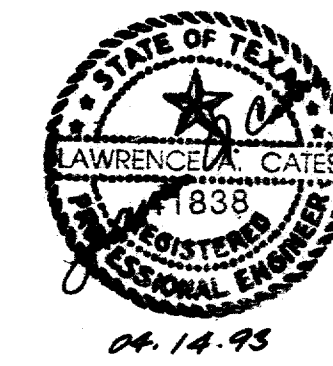

04.14.95

LINES SD 20, 21, 2.2, 2.3, 2.4 & 2.5

STORM SEWER PROFILES
ADDISON TOWN CENTER
TOWN OF ADDISON, TEXAS

| DESIGN | DRAWN | DATE | SCALE | NOTES | FILE | NO. |
|--------|-------|--------|-----------------------|-------|------|------|
| LAC | LAC | 4/7/93 | H: 1"=40' V: 1"=6' | D.P. | 9102 | C-12 |