

PLAN
1" = 2'-0"


- GENERAL NOTES
1. CONCRETE SHALL HAVE A MINIMUM COMPRESSIVE STRENGTH OF $f'c = 3000$ PSI AT 28 DAYS.
 2. REINFORCING STEEL $F_y = 40$ KSI.
 3. BAR LAPS SHALL BE 30" DIAMETERS.
 4. EXPOSED EDGES AND CORNERS TO BE CHAMFERED 1/4".

AS-BUILTS
I CERTIFY THIS PROJECT WAS CONSTRUCTED IN GENERAL CONFORMANCE WITH THESE CONSTRUCTION PLANS AND WILL FUNCTION AS DESIGNED.



• DENOTES CONCRETE REMOVAL

REV. 6-10-93 Added 27" RCP TO Junc. Box

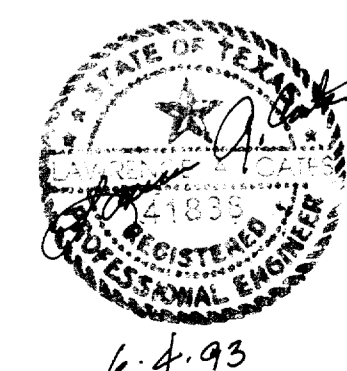

84" RCP JUNCTION BOX DETAILS						
KMART NO. 4885						
BELTLINE AND MARSH						
ADDISON, TEXAS						
LAWRENCE A. CATES & ASSOC.						CONSULTING ENGINEERS DALLAS, TEXAS
DESIGN	DRAWN	DATE	SCALE	NOTES	FILE	NO.
LAC	LAC	6-4-93	1" = 2'-0"		91012	C-17