



**DRAINAGE SUMMARY**

AREA	ACRES	C	I100	Q100	REMARKS	
A1	0.68	0.9	8.74	5.35	5.35	INC. ROOF DRAIN-BLDG. A
A2	0.87	0.5	8.74	3.80	9.15	FROM RES. SUBD.
A3	0.56	0.9	8.74	4.40	13.55	TO 10" C.I.
A4	2.68	0.9	8.74	21.13	34.88	KMART ROOF DRAINAGE
A5	1.18	0.4	7.70	5.60	38.28	PARK AREA
A6	0.49	0.9	8.74	3.85	41.93	TO 10" C.I.
A7	0.15	0.9	8.74	1.61	1.61	GARDEN SHOP DRAINAGE
A8	0.44	0.9	8.74	3.46	47.00	TO 6" C.I.
A9	0.36	0.9	8.74	2.83	2.83	TO 6" C.I.
B1	1.96	0.5	8.74	8.56	8.56	FROM SUBD. TO 54"
B2	4.45	0.45	7.70	15.40	15.40	PARK AREA
B3	1.46	0.9	8.74	11.48	11.48	TO 14" C.I.
B4	1.24	0.9	8.74	9.75	9.75	WINN-DIXIE ROOF DRAIN
B4-1	1.84	0.9	8.74	14.75	24.22	8" GRATE INLET
B5	0.10	0.9	8.74	0.79	0.79	BLDG. B ROOF DRAIN
B6	1.44	0.5	8.74	6.29	6.29	FROM SUBD. (6" CI)
B7	2.75	0.4	7.70	8.16	14.76	FUTURE PARK TO 3x3 DROP
BB-1	1.51	0.9	8.74	11.88	11.88	TO 10" CI
BB-2	2.81	0.9	8.74	22.10	22.10	TO 2X10" CI
BB-3	2.08	0.9	8.74	18.36	18.36	TO 14" CI
BB-4	0.63	0.9	8.74	4.97	4.97	TO 6" CI
BB-5	1.08	0.9	8.74	8.50	8.50	TO 10" CI
BB-6	0.57	0.9	8.74	4.90	4.90	TO EX. 10" C.I.
B-9	0.73	0.90	8.74	5.7	5.7	TO 6" FLUME
B-10	0.48	0.40	7.70	1.5	7.2	TO PROP. SWALE (PARK)
B-11	0.21	0.90	8.74	1.7	8.9	TO 3" FLUME
B-12	0.57	0.90	8.74	4.5	13.4	PROP. SWALE TO 3'x3' D.I.
B-13	0.44	0.90	8.74	3.5	16.9	TO 10" C.I.
B-14	0.57	0.90	8.74	4.5	21.4	TO 10" C.I.
B-15	0.46	0.90	8.74	3.6	28.00	TO 10" C.I.
C1	1.22	0.9	8.74	9.80	9.80	TO 10" C.I.
C2	2.64	0.9	8.74	20.80	30.40	TO 20" C.I.
D1	1.66	0.9	8.74	13.06	13.06	FUTURE LOT 1, BLK D
D2	0.21	0.9	8.74	1.57	14.83	TO 6" C.I.
D3	0.61	0.9	8.74	4.80	4.80	TO 10" C.I.
D4	0.93	0.9	8.74	7.31	26.74	TO 10" C.I.
E1	1.58	0.9	8.74	12.43	12.43	TO 10" C.I.
E2	0.88	0.9	8.74	6.92	6.92	TO 10" C.I.
E3	0.60	0.9	8.74	4.72	11.56	TO 10" C.I.
F1	0.53	0.9	8.74	4.17	4.17	TO 6" C.I.
G1	0.55	0.9	8.74	4.33	4.33	TO 10" C.I.
G2	0.85	0.9	8.74	6.89	6.89	TO 10" C.I.
H1	2.00	0.9	8.74	15.73	15.73	FUTURE LOT 2
J1	0.18	0.9	8.74	1.42	1.42	TO EXIST. INLET
K	0.12	0.9	8.74	0.94	0.94	TO BELT LINE ROAD
L1	0.90	0.45	7.70	3.12	3.12	FUTURE PARK
L2	5.56	0.9	8.74	43.74	48.86	FUTURE RETAIL
OS-1	175.00	0.60	6.8	714	714	FROM 96" RCP
OS-2	414.00	0.80	4.8	1590	1590	FROM AREA N. OF BELT LINE
OS-3	18.73	0.90	7.7	116	116	54" (BUSINESS DR.)
OS-4	01.14	0.90	8.7	9	9	FROM BELT LINE RD.
OS-5	62.00	0.52	7.6	248	245	4" GRATE INLET
OS-6	17.60	0.90	7.7	122	122	54" TO LOW PT. @ BELTLINE

AS-BUILTS  
 I CERTIFY THIS PROJECT WAS CONSTRUCTED IN GENERAL CONFORMANCE WITH THESE CONSTRUCTION PLANS AND WILL FUNCTION AS DESIGNED.

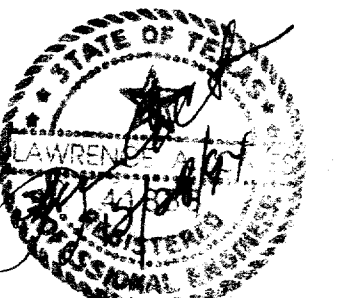

THE SEAL APPEARING ON THIS DOCUMENT WAS AUTHORIZED BY DONALD F. WARNKE JR., P.E. 66671 ON 01/21/94

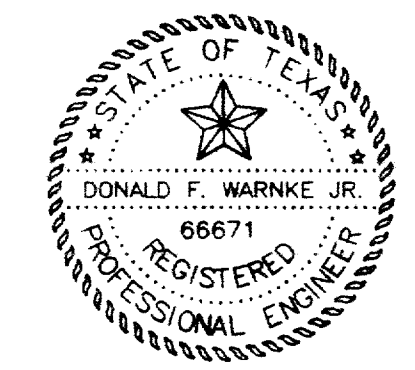

5/12/94 ADDED BABY SUPERSTORES						
<b>DRAINAGE AREA MAP</b>						
COMP USA						
ADDISON TOWN CENTER						
TOWN OF ADDISON, TEXAS						
LAWRENCE A. CATES & ASSOC. CONSULTING ENGINEERS DALLAS, TEXAS						
DESIGN	DRAWN	DATE	SCALE	NOTES	FILE	NO.
LAC	LAC		1"=100'	D.P.	94044 DRNGMAP.DWG	C-9