
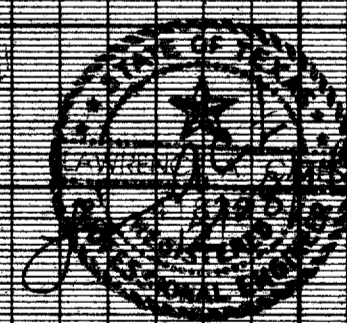


BENCH MARK:
 N.W. CORNER OF
 SOUTH SIDE OF B
 575' WEST OF T
 ROAD AND BUSIN
 ELEV. 573.06'

BENCH MARK:
 " " CUT ON STORM SEWER INLET ON
 SOUTH SIDE OF BELT LINE ROAD 70'±
 WEST OF COMMERCIAL DRIVE.
 ELEV. 580.56'

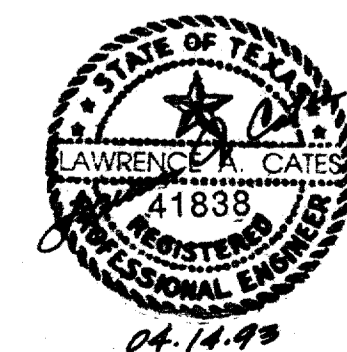

NOTES:
 1. VERIFY THAT PROJECT WAS CONSTRUCTED IN ACCORDANCE WITH THESE CONSTRUCTION PLANS AND SHALL BE ACCORDING TO SPECIFICATIONS.

REV. 04.30.93 - CHG. 96 GRADE & LATERAL

LINE A & LINE B						
SANITARY SEWER PROFILES						
ADDISON TOWN CENTER						
TOWN OF ADDISON, TEXAS						
LAWRENCE A. CATES & ASSOC.						CONSULTING ENGINEERS DALLAS, TEXAS
DESIGN	DRAWN	DATE	SCALE	NOTES	FILE	NO.
LAC	LAC	04/07/93	H: 1"=40' V: 1"=6'	D.P.	91012	C-9