


SITework PLANS FOR LOT 2, BLOCK 1 - EXWEN ADDITION ADDISON TOWN CENTER TOWN OF ADDISON, TEXAS

SHEET INDEX

C-1	DIMENSION CONTROL PLAN
C-2	TOPOGRAPHIC SURVEY
C-3	PAVING PLAN
C-4	GRADING & DRAINAGE PLAN
C-5	WATER & SANITARY SEWER PLAN
C-6	EROSION CONTROL PLAN
C-7	STORM DRAIN DETAILS
C-8	DRAINAGE AREA MAP
C-9	SANITARY & STORM SEWER PROFILES

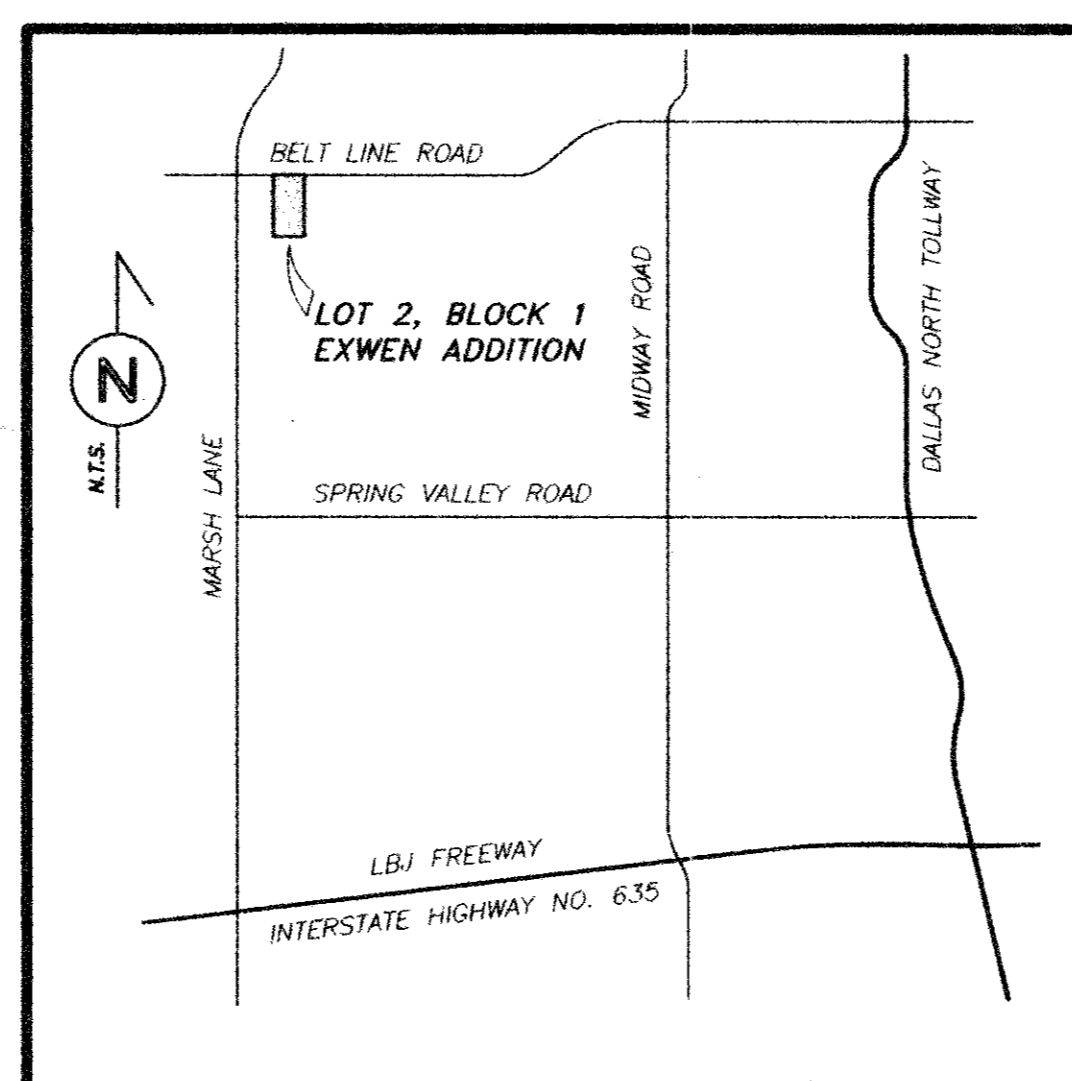

VICINITY MAP

DEVELOPER:
HUNT PROPERTIES, INC.
8235 DOUGLAS AVENUE, SUITE 1300
DALLAS, TEXAS 75225
(214) 360-9600
CONTACT: DAVE BERNDT

PROJECT ARCHITECT:
ENVIROPLAN
8235 DOUGLAS AVENUE, SUITE 350
DALLAS, TEXAS 75225
(214) 692-0851
FAX: (214) 739-6849
CONTACT: GARY JOHNSON

CIVIL ENGINEER:
LAWRENCE A. CATES & ASSOCIATES, INC.
14200 MIDWAY ROAD, SUITE 122
DALLAS, TEXAS 75244
(972) 385-2272
FAX: (972) 980-1627
CONTACT: DAVE WALLS

AS BUILT
DATE 13 Jun 98