


AS-BUILTS
 I CERTIFY THIS PROJECT WAS CONSTRUCTED IN GENERAL CONFORMANCE WITH THESE CONSTRUCTION PLANS AND WILL FUNCTION AS DESIGNED.

NOTE: SEE SHEET GN-12 FOR LOT GRADING GENERAL NOTES.

- LEGEND**
- TC TOP OF CURB
 - FP FINISH PAD + 0.7' = FINISH FLOOR
 - PROP. INLET
 - 591- EXIST. CONTOUR
 - 93- PROP. CONTOUR

BENCHMARK:
 "□" CUT ON STORM SEWER INLET ON SOUTH SIDE OF BELT LINE ROAD 70'± WEST OF COMMERCIAL DRIVE.
 ELEV. 580.56'

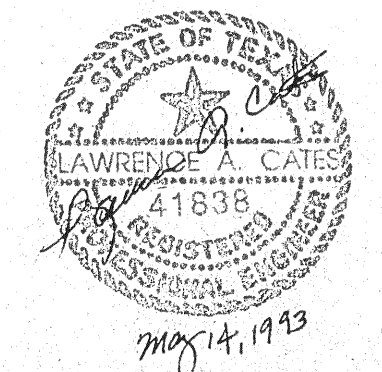

LOT GRADING PLAN						
ADDISON TOWN CENTER SUBDIVISION						
TOWN OF ADDISON, TX.						
LAWRENCE A. CATES & ASSOC.						CONSULTING ENGINEERS
						DALLAS, TEXAS
DESIGN	DRAWN	DATE	SCALE	NOTES	FILE	NO.
L.A.C.	L.A.C.		1" = 40'		92096	C-1.0