


AS-BUILTS
 CERTIFY THIS PROJECT WAS CONSTRUCTED IN GENERAL CONFORMANCE WITH THESE CONSTRUCTION PLANS AND WILL FUNCTION AS DESIGNED.

REV. 04.30.93 - CH. 5% GRADE & MATERIAL

BENCHMARK:
 N.W. CORNER OF EXISTING CURB INLET LOCATED ON SOUTH SIDE OF BELT LINE ROAD. INLET LOCATED 575' WEST OF THE INTERSECTION OF BELT LINE ROAD AND BUSINESS AVENUE.
 ELEV. 573.06'

BENCHMARK:
 " " CUT ON STORM SEWER INLET ON SOUTH SIDE OF BELT LINE ROAD 70'± WEST OF COMMERCIAL DRIVE.
 ELEV. 580.56'

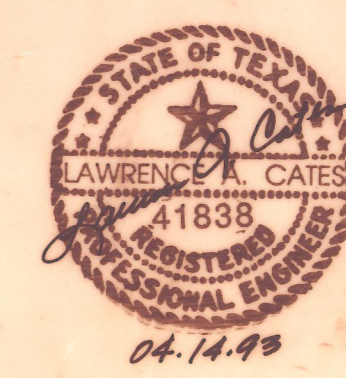

LINE A & LINE B						
SANITARY SEWER PROFILES						
ADDISON TOWN CENTER						
TOWN OF ADDISON, TEXAS						
LAWRENCE A. CATES & ASSOC. CONSULTING ENGINEERS DALLAS, TEXAS						
DESIGN	DRAWN	DATE	SCALE	NOTES	FILE	NO.
LAC	LAC	04/07/93	H: 1"=40' V: 1"=6'	D.P.	91012	C-9

FF-4