

**STORM SEWER PROFILES**  
 LN, SD 1.0, 5.0 & 7.0  
**KMART No. 4885**  
 TOWN OF ADDISON, TEXAS  
 LAWRENCE A. CATES & ASSOC.  
 CONSULTING ENGINEERS  
 DALLAS, TEXAS


DESIGN	LAC	DATE	SCALE	NOTES	FILE	NO.
LAC	LAC	4/07/93	H: 1"=40' V: 1"=5'	D.P.	91012	C-14



BENCH MARK:  
 N.W. CORNER OF EXISTING CURB INLET LOCATED ON SOUTH SIDE OF BELT LINE ROAD. INLET LOCATED SOUTH SIDE OF BELT LINE ROAD 70' WEST OF COMMERCIAL DRIVE.  
 ELEV. 573.06'

BENCH MARK:  
 " " CUT ON STORM SEWER INLET ON SOUTH SIDE OF BELT LINE ROAD 70' WEST OF COMMERCIAL DRIVE.  
 ELEV. 580.56'

AS-BUILT  
 I CERTIFY THIS PROJECT WAS CONSTRUCTED IN GENERAL CONFORMANCE WITH THESE CONSTRUCTION PLANS AND WILL FUNCTION AS DESIGNED.

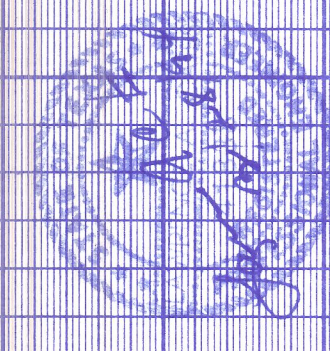

Check of 30' AS-BUILT ACKNOWLEDGMENT FILE FILE CITY