

# REPLAT WESTGROVE AND AIRBORN

BEING A REPLAT OF BLOCK A, CARROLL ESTATES  
TOWN OF ADDISON, DALLAS COUNTY, TEXAS


PW # 2008-06

## INDEX

DESCRIPTION	SHEET NO.
COVER SHEET	1
FINAL PLAT	2
SITE PLAN	3
DEMOLITION PLAN	4
GRADING PLAN	5
DRAINAGE PLAN	6
DETENTION POND	7
STORM WATER POLLUTION PREVENTION PLAN	8
CONCRETE PAVING PLAN & JOINT DETAILS	9
UTILITY PLAN	10
SITE DETAILS	11
LANDSCAPE PLAN	12
IRRIGATION PLAN	13-14

## VICINITY MAP

SCALE 1" = 600'

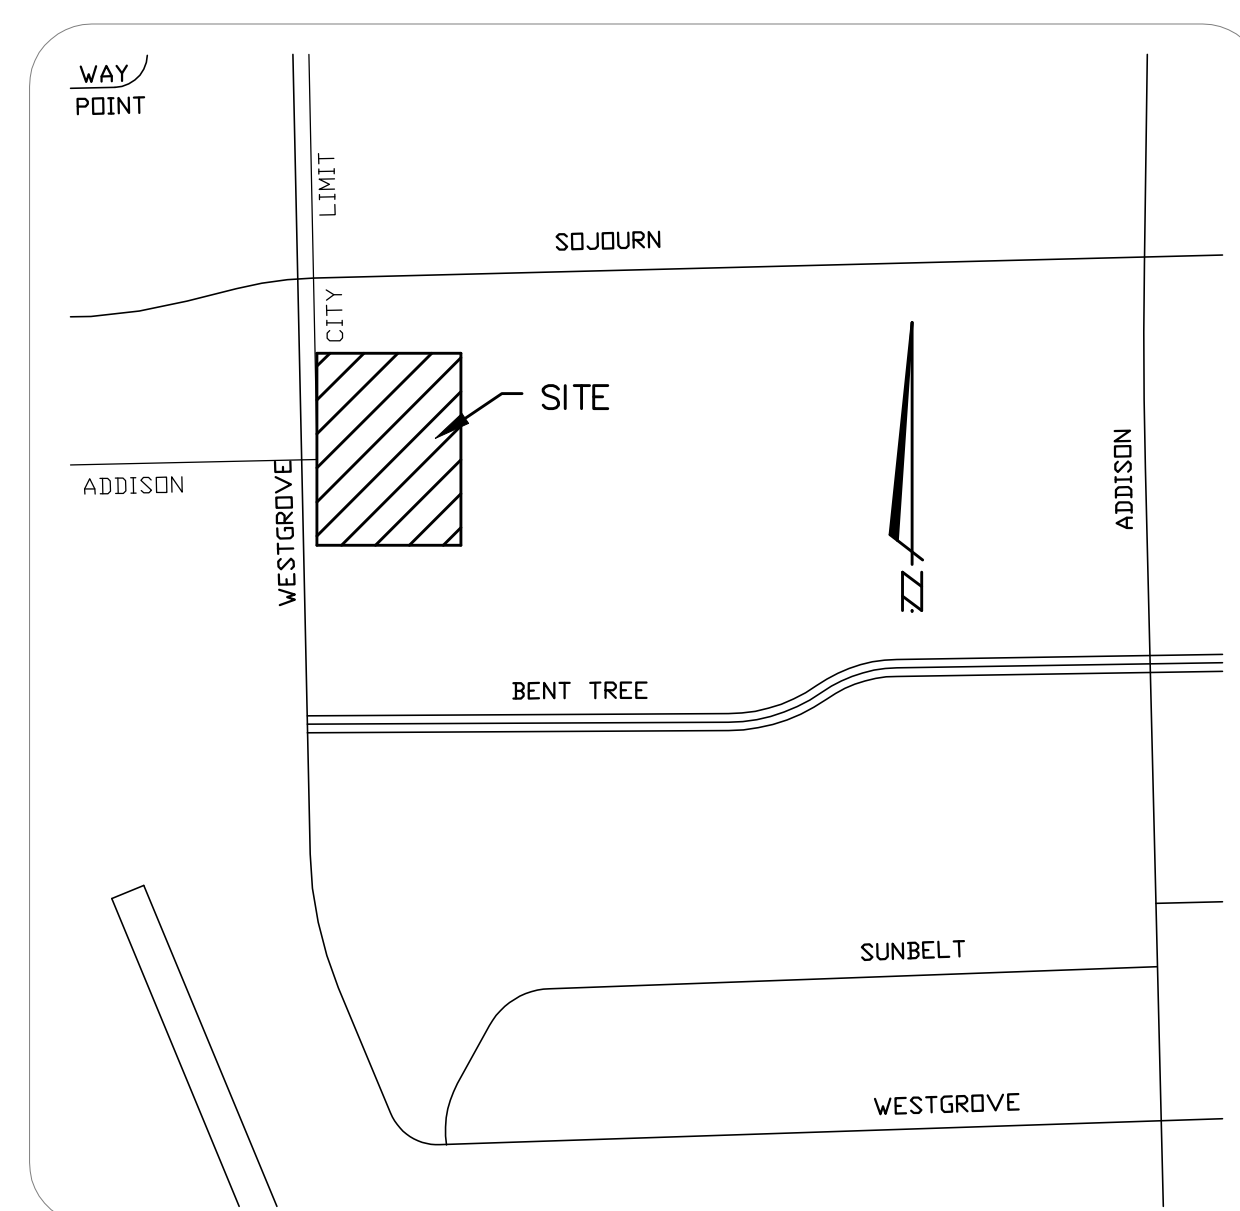


G. GLEN KISTENMACHER  
Registered Professional Engineer, Texas No. 65021.

**AS BUILT**  
APRIL 30, 2010

REVISED: SEPTEMBER 18, 2008  
REVISED: AUGUST 3, 2008

DATE JUNE 16, 2008

SHEET 1 OF 14

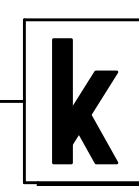

KISTENMACHER ENGINEERING COMPANY, INC.

CONSULTING ENGINEERING • LAND PLANNING • SURVEYING  
1420 GERONIMO DRIVE, SUITE A2 • EL PASO, TEXAS 79925 • (915) 778-4476  
6336 GREENVILLE AVE, SUITE C • DALLAS, TEXAS 75206 • (214) 234-0011