
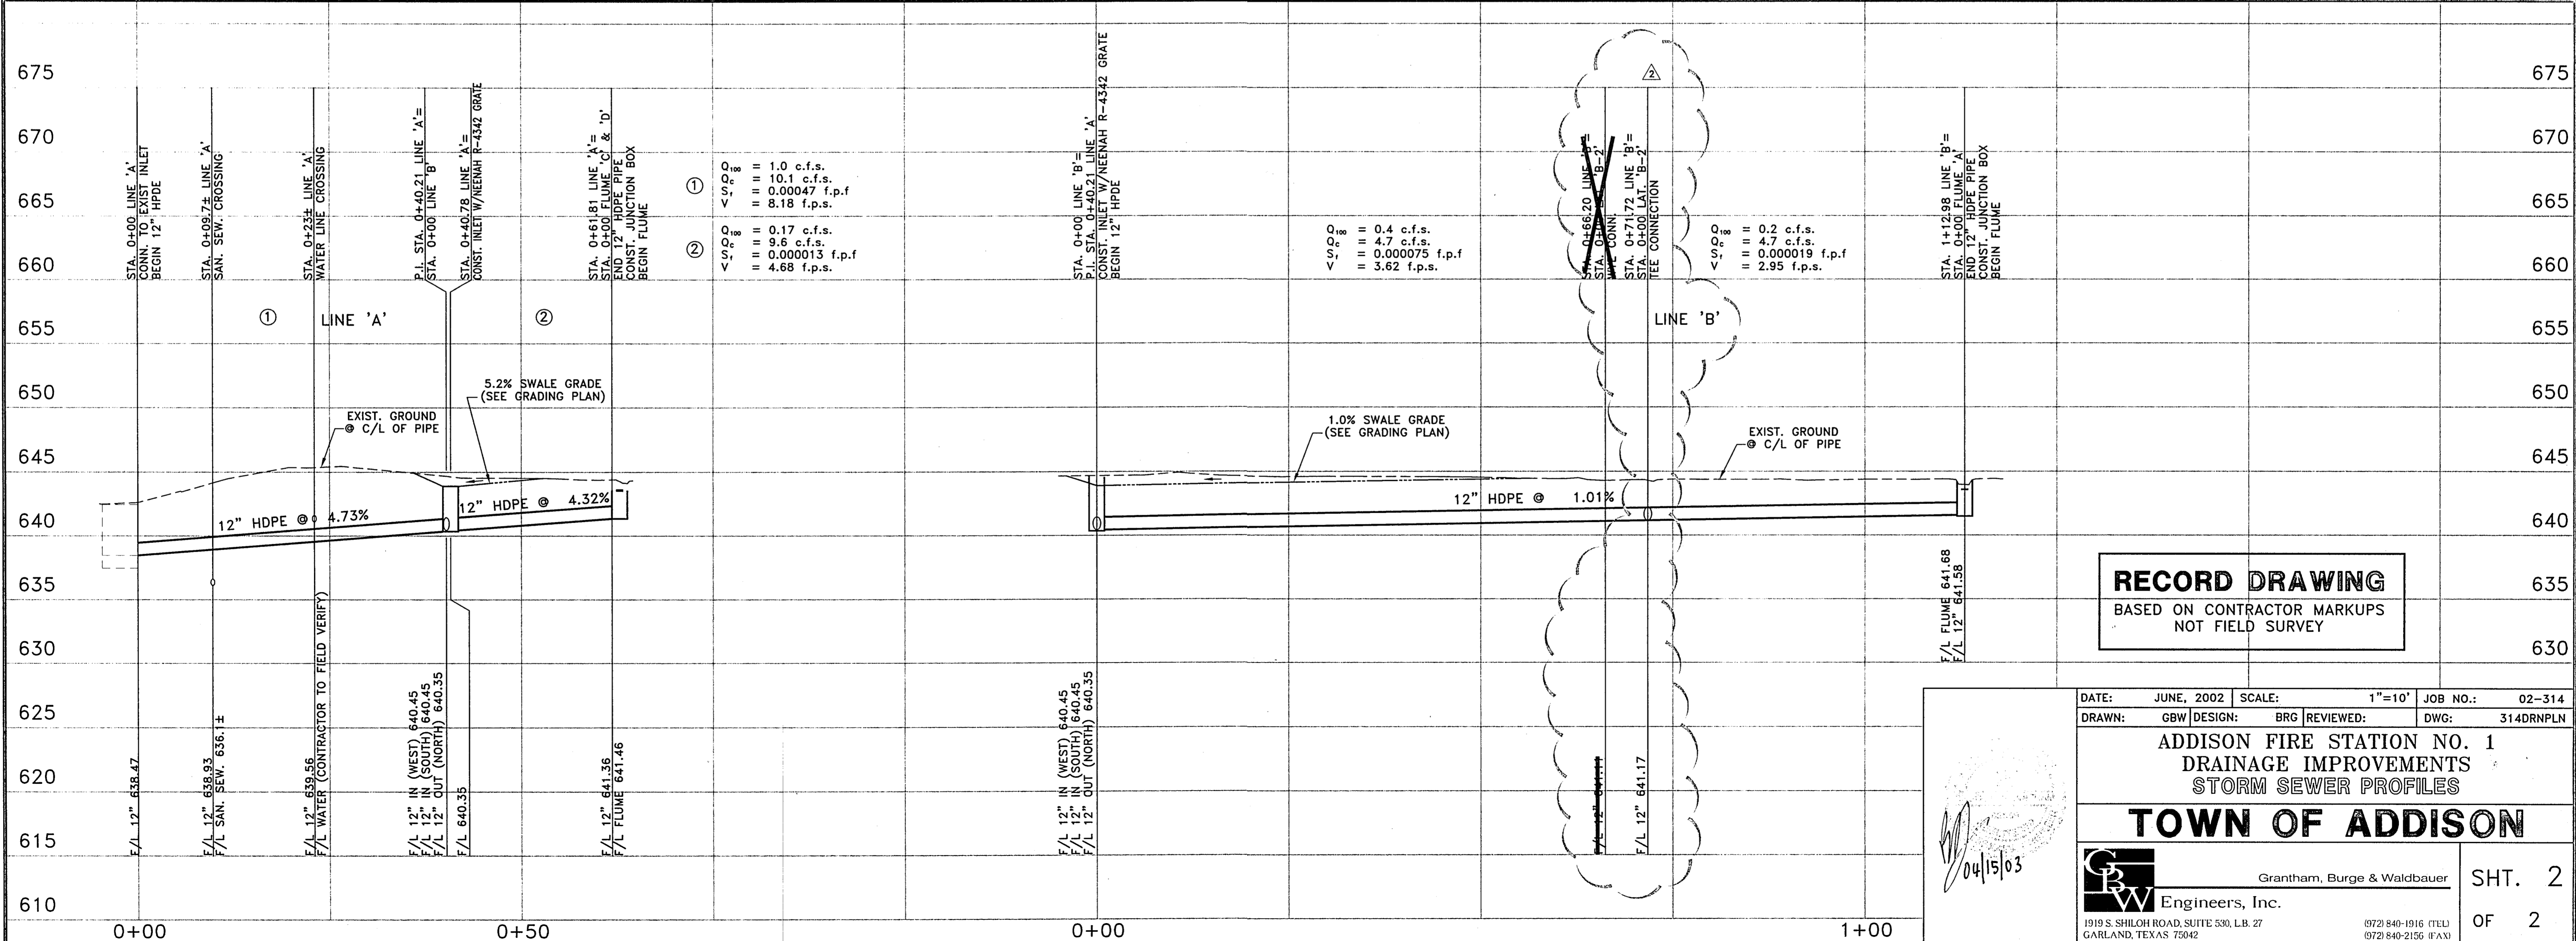


NO.	DATE	REVISION	APPROV.
△	8-27-02	REVISED PER ADDENDUM NO. 1	BG
△	3-27-03	REVISED PER CONTRACTOR'S MARK-UPS	BG
3			

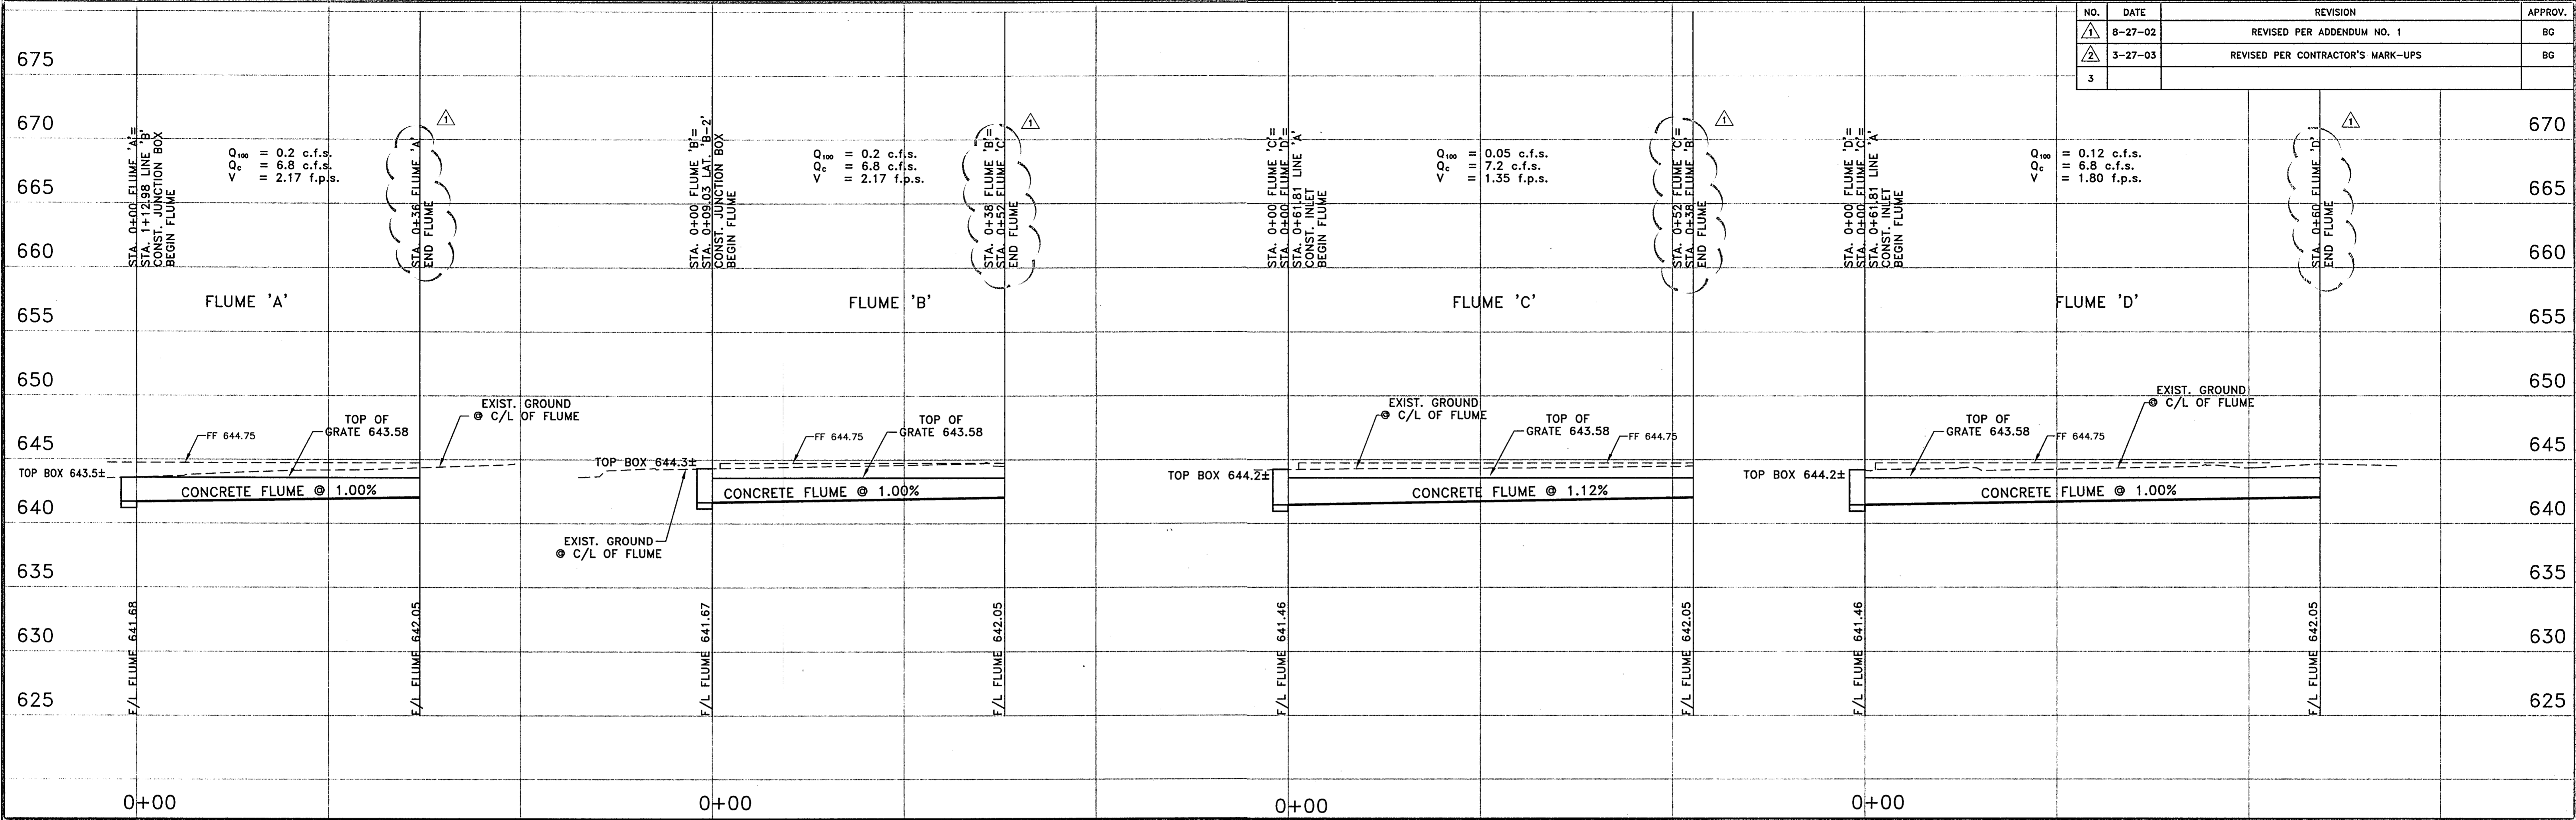

**RECORD DRAWING**  
 BASED ON CONTRACTOR MARKUPS  
 NOT FIELD SURVEY

04/15/03

DATE:	JUNE, 2002	SCALE:	1"=10'	JOB NO.:	02-314
DRAWN:	GBW	DESIGN:	BRG	REVIEWED:	DWG: 314DRNPLN
<b>ADDISON FIRE STATION NO. 1 DRAINAGE IMPROVEMENTS STORM SEWER PROFILES</b>					
<b>TOWN OF ADDISON</b>					
Grantham, Burge & Waldbauer Engineers, Inc.					SHT. 2 OF 2
1919 S. SHILOH ROAD, SUITE 530, L.B. 27 GARLAND, TEXAS 75042			(972) 840-1916 (TEL) (972) 840-2150 (FAX)		