


FEDERAL EXPRESS FACILITY

DIENNA \ SIMPKINS COMPANY

PAVING, GRADING, AND DRAINAGE PLANS

SHEET INDEX

FP-1	PLAT
G-1	GRADING PLAN
P-1	PAVING PLAN
DA-1	DRAINAGE AREA MAP
STM-1	STORM SEWER PLAN
STM-2	STORM SEWER PROFILES
EC-1	EROSION CONTROL

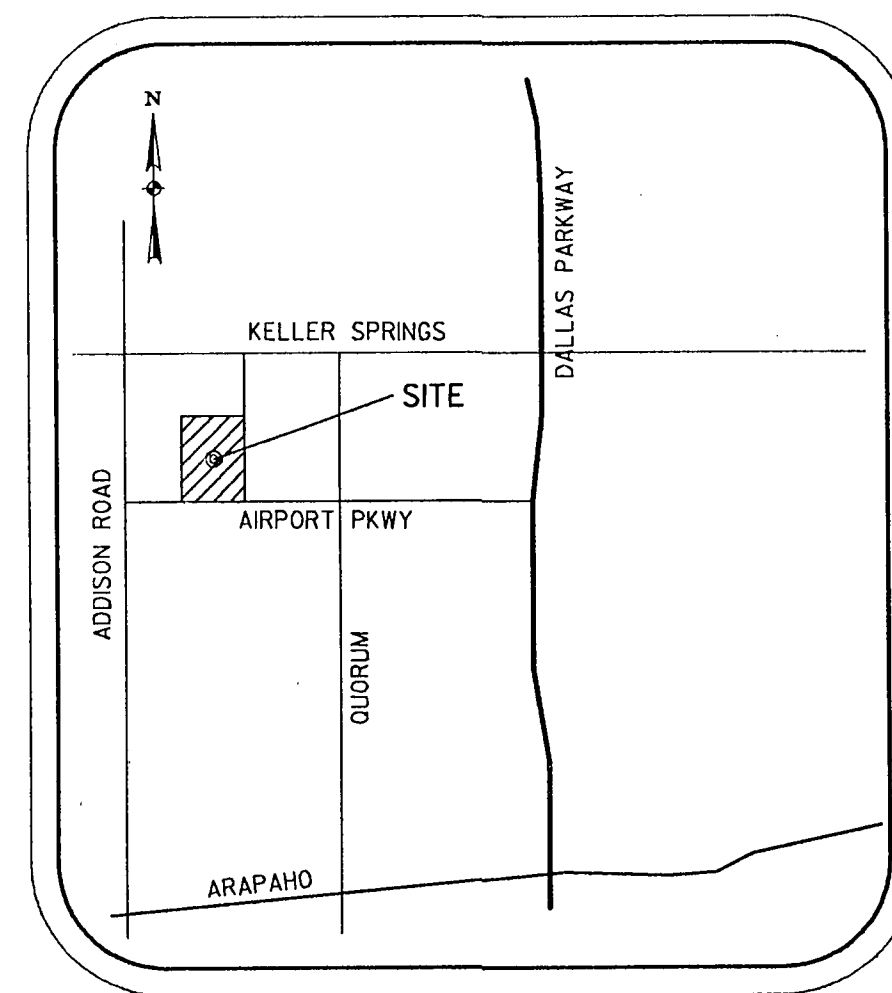


LOCATION MAP

HALFF ASSOCIATES, INC.

8616 NORTHWEST PLAZA DRIVE DALLAS TEXAS (214) 739-0094

AVO 13957 NOV 1994

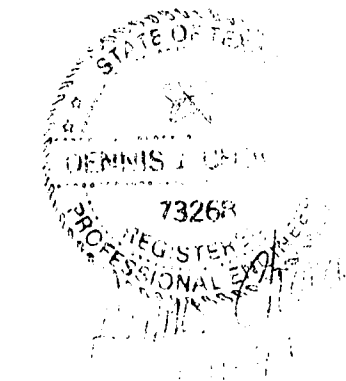

"AS BUILT PLANS"

All improvements shown on these plans and placed within the Town of Addison's right-of-way or easement were constructed in compliance to the Town of Addison Standards and Specifications and functions as designed.