


DRAINAGE AREA		COEFFICIENT OF RUNOFF	DESIGN FREQUENCY	INTENSITY	DISCHARGE	INLET TYPE	INLET CAPACITY
INCREMENT AREA	NO. AREA						
	ACRES	YEARS	IN/HR	CFS		CFS	
A	1.20	0.8	100	8.74	8.39	4 GI	12.8
B	0.61	0.8	100	8.74	4.26	2 GI	6.4
C	0.63	0.8	100	8.74	4.40		
D	0.34	0.8	100	8.74	2.40		
E	0.86	0.8	100	8.74	6.01		
F	0.19	0.8	100	8.74	1.32		
G	0.84	0.8	100	8.74	5.87	2 GI	6.4
H	0.80	0.8	100	8.74	5.59	2 GI	6.4

"AS BUILT PLANS"
 All improvements shown on these plans and placed within the Town of Addison's right-of-way or easement were constructed in compliance to the Town of Addison Standards and Specifications and functions as designed.

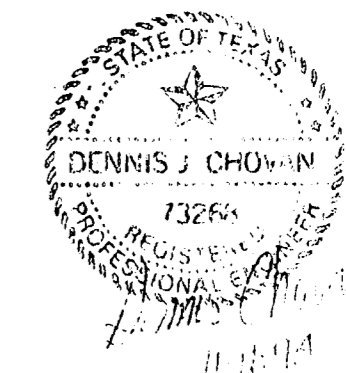

DRAINAGE AREA MAP

REVIS 10/26/94, INLET CALCULATIONS

HALF ASSOCIATES, INC.
 ENGINEERS • ARCHITECTS • PLANNERS • SURVEYORS

MUNSON KENNEDY PARTNERSHIP

DIENNA / SIMPKINS COMPANY
 REAL ESTATE DEVELOPMENT
 1400 POST OAK BLVD., SUITE 1100
 HOUSTON, TEXAS 77056
 713/666-1222

62 VAN CITY STATION FACILITY

ADDISON, TEXAS

PROJECT 94/G
 DATE 11-11-94
 REVISIONS 1
 SHEET DA-1
 PAGE 4 OF 49