



**"AS BUILT PLANS"**  
 All improvements shown on these plans and placed within the Town of Addison's right-of-way or easement were constructed in compliance to the Town of Addison Standards and Specifications and functions as designed.

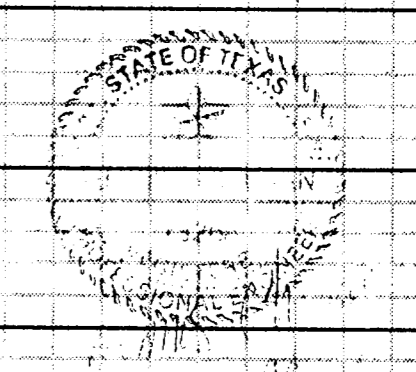

BENCHMARK  
 '1' CUT AT CL 16 FOOT CURB INLET APPROX. 300 FT NORTH OF AIRPORT PKWY ALONG EAST PROPERTY LINE.  
 ELEVATION 636.90

**STORM SEWER PROFILE**

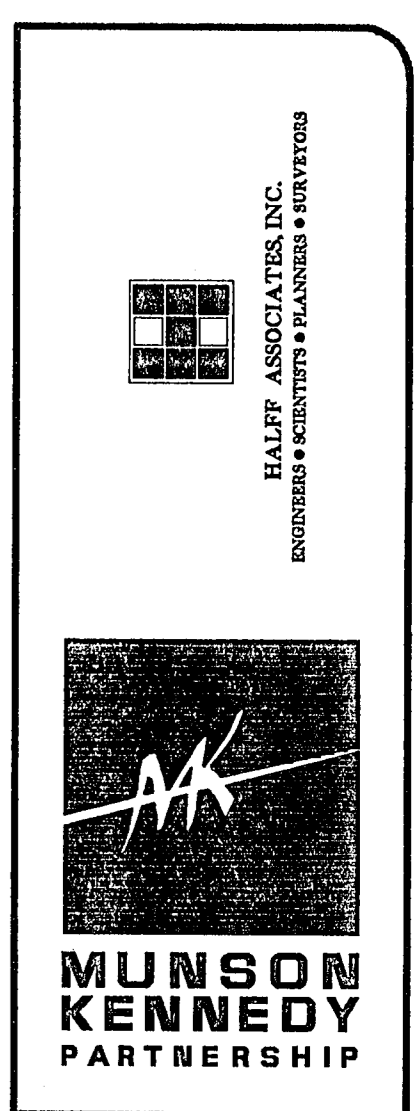

**DIENNA / SIMPKINS COMPANY**  
 REAL ESTATE DEVELOPMENT  
 1400 POST OAK BLVD., SUITE 1100  
 HOUSTON, TEXAS 77056  
 713/686-1222

62 VAN CITY STATION FACILITY  
**FOOTEX**  
 ADDISON, TEXAS

PROJECT 94/G  
 DATE 11-11-94  
 REVISIONS 1  
 SHEET STM-2  
 PAGE 6 OF 49