



PLANS FOR THE CONSTRUCTION OF
GRADING, PAVING AND STORM SEWER
IMPROVEMENTS FOR

AIRPORT PARKWAY REALIGNMENT


ADDISON AIRPORT



SHEET NO.	INDEX OF SHEETS
	COVER SHEET
PL-1	PROJECT LAYOUT
N-1 TO N3	GENERAL NOTES
Q-1	QUANTITY SHEETS
R-1	RIGHT-OF-WAY PLAN
RM-1	REMOVAL PLAN
TY-1	TYPICAL SECTIONS
PP-1 TO PP-2	PAVING PLAN AND PROFILE
JL-1	JOINT LAYOUT
PD-1	PAVING DETAILS
EC-1	EROSION CONTROL PLAN
D-1	STORM SEWER PLANS AND PROFILES
MD-1	MISCELLANEOUS DETAILS
XS-1 TO XS-5	CROSS SECTIONS
IL-1	ILLUMINATION PLAN
FD-1	FENCE DETAILS

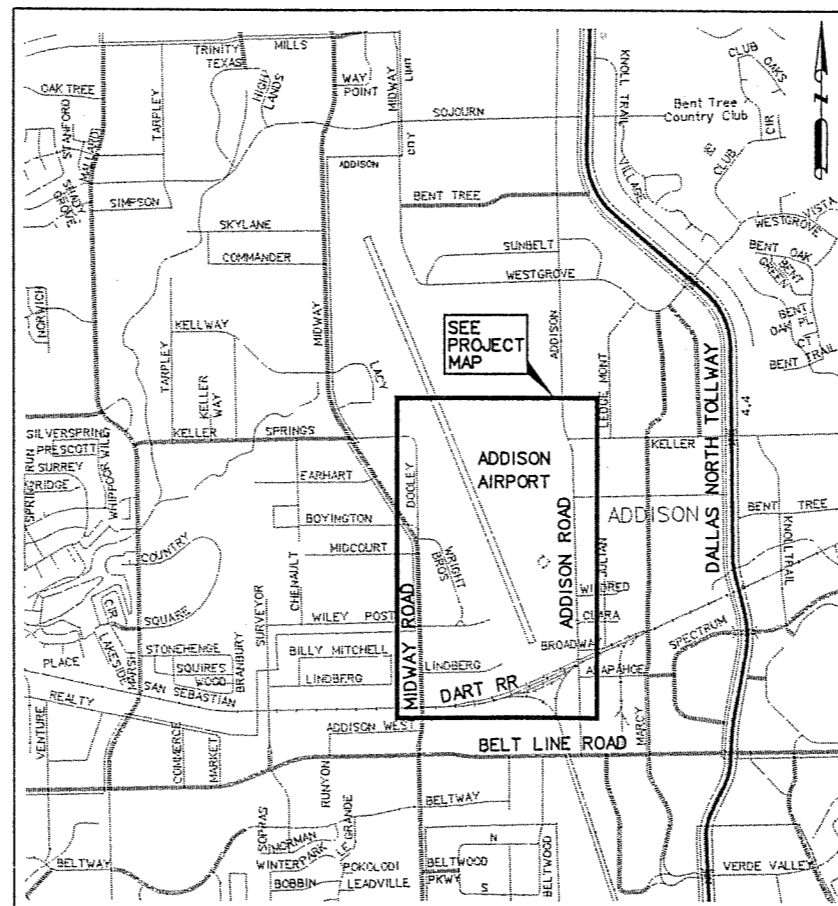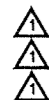

LOCATION MAP
NOT TO SCALE

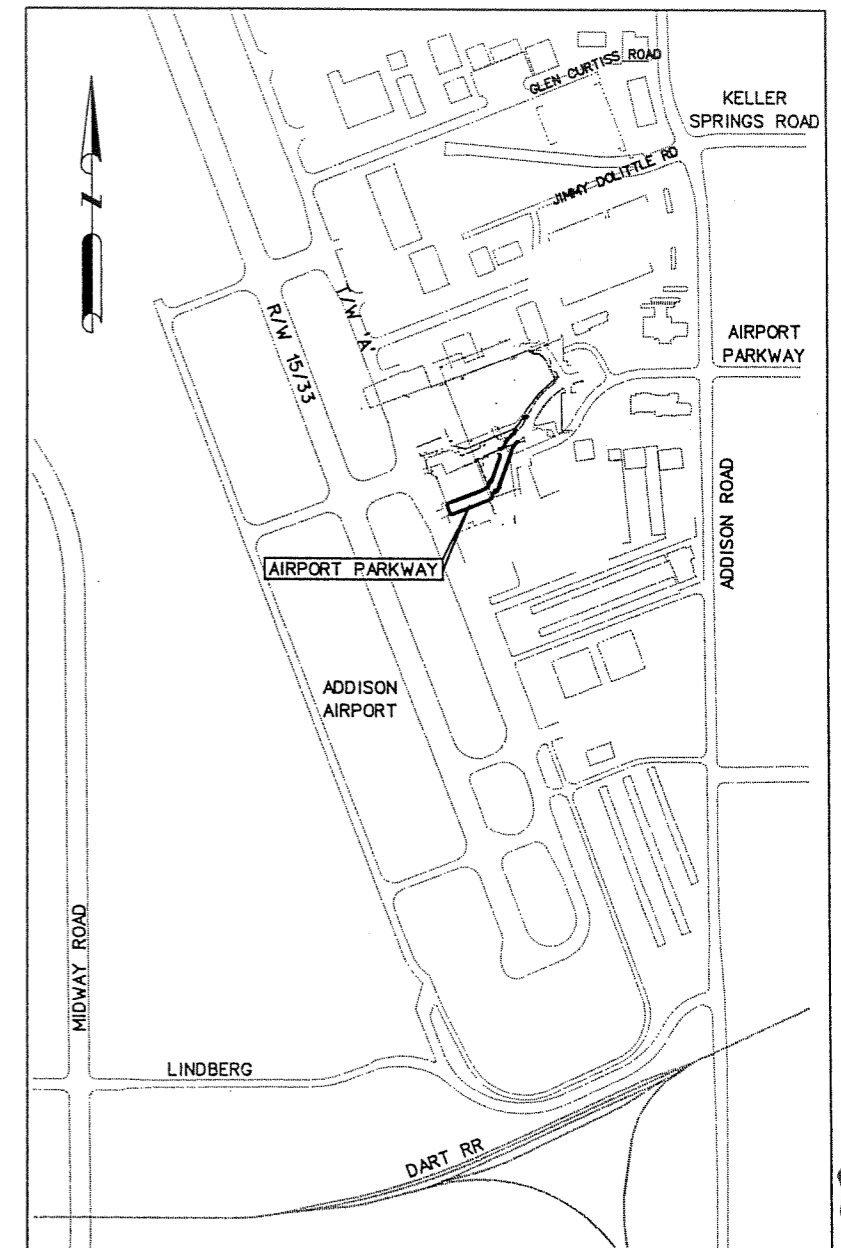

PROJECT MAP
NOT TO SCALE

FF-13

JAN 14 2004

OWNER:
TOWN OF ADDISON
DEPARTMENT OF PUBLIC WORKS
16801 WESTGROVE
P.O. BOX 144
ADDISON, TEXAS 75001
(972) 450-2886

ENGINEER:
HNTB CORPORATION
5910 WEST PLANO PARKWAY, SUITE 200
DALLAS, TEXAS 75093
(972) 661-5626

CT-2003 21:06
9020\cadd\Sheets\ppcover.dgn

FF-12

"As-Builts"