

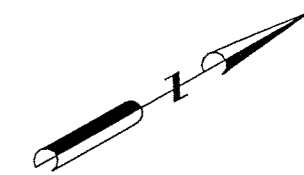


- LEGEND**
- \*\*\*\*\* SILT FENCE
  - (IP) INLET PROTECTION
  - ▲ TEMPORARY ROAD

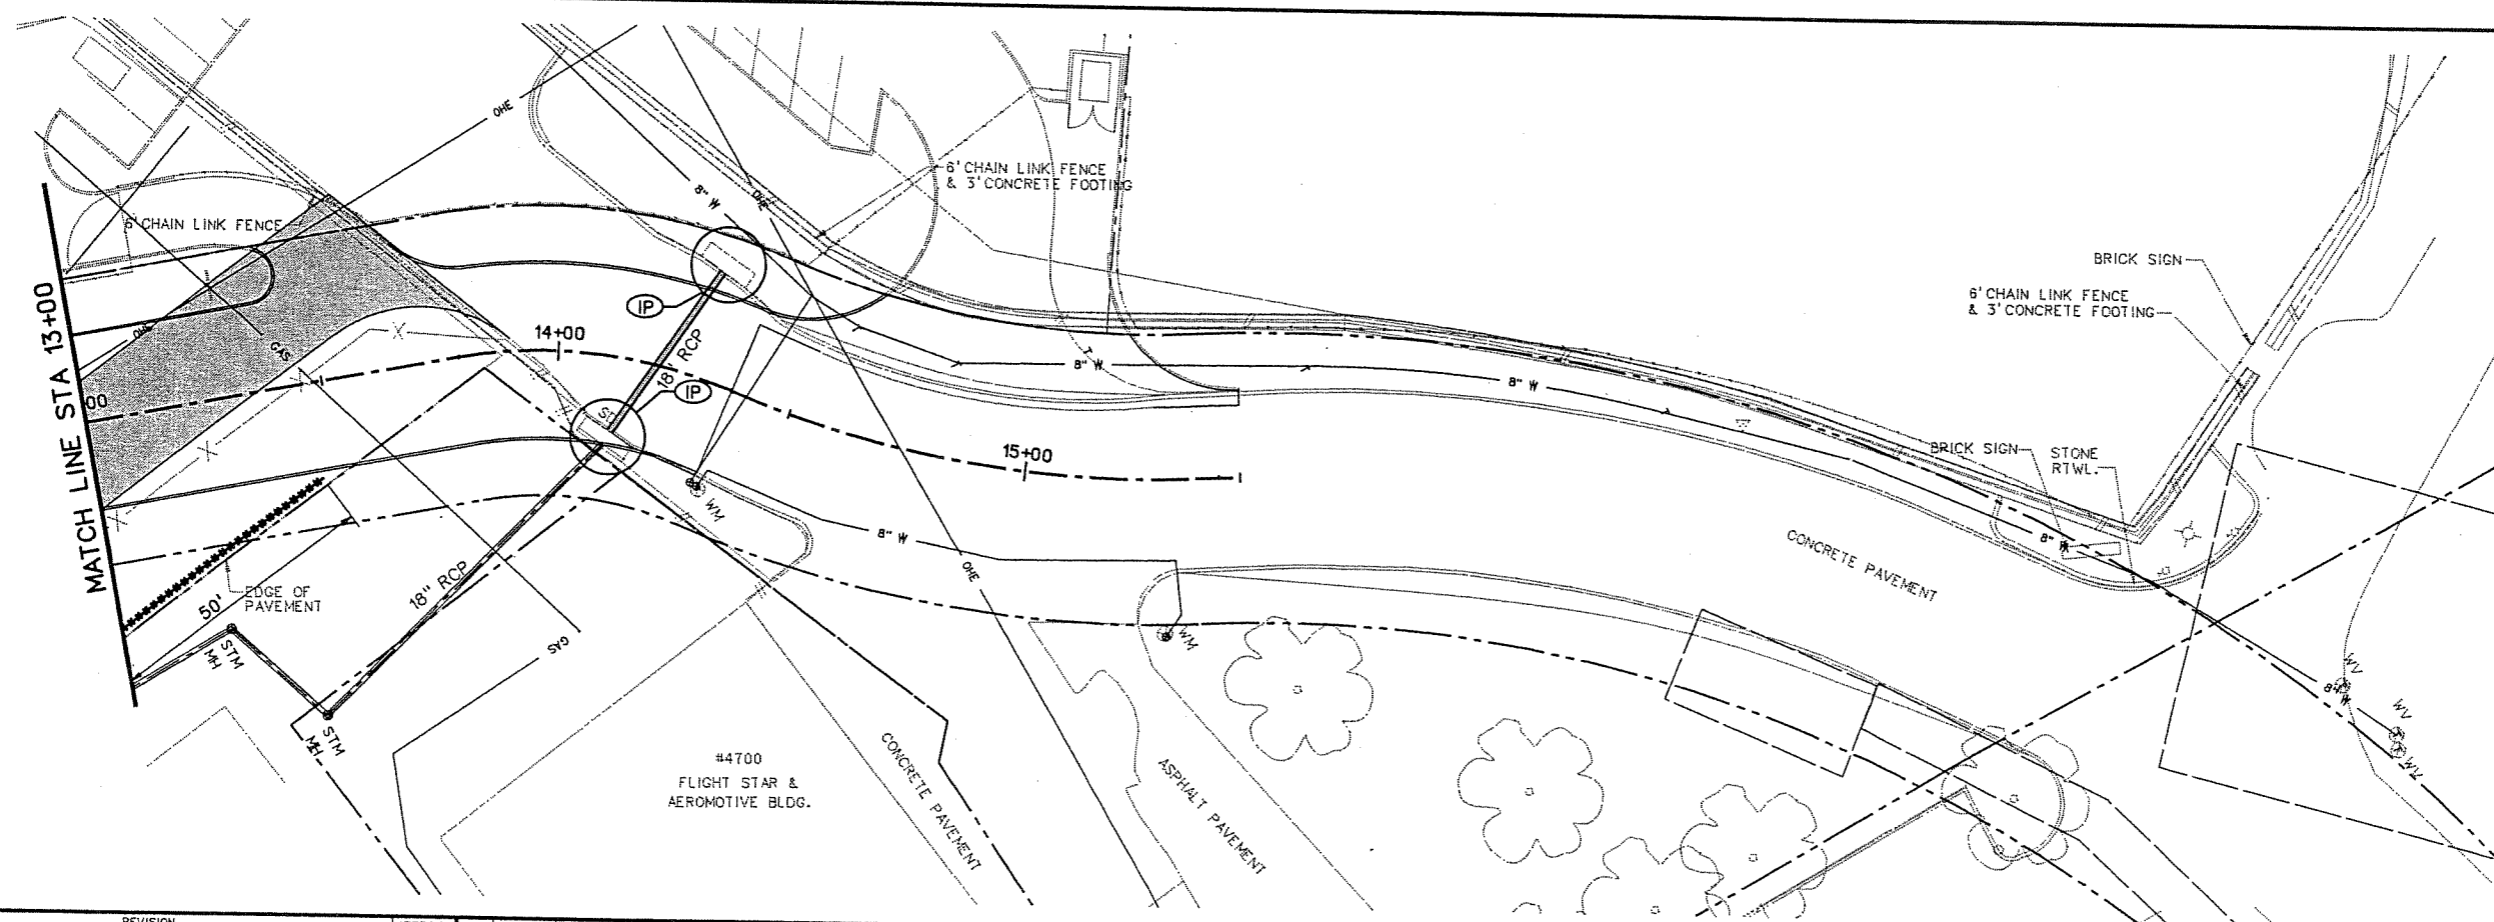

-OCT-2003 21:08 \\339020\Cad\Sheets\opsw3p01.dgn

NO.	DATE	REVISION	APPROV.	NO.	DATE	REVISION	APPROV.
1	10/10/03	LEGEND MODIFIED	JSN				

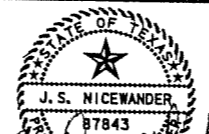

10/10/03

**HNTB** ARCHITECTS ENGINEERS PLANNERS  
The HNTB Companies

DESIGN CHECK	JSN	PROJECT NO.	39020
DRAWN	JDH		
CHECK	GFS		
DATE	SEPTEMBER 2003		



**TOWN OF ADDISON**  
AIRPORT PARKWAY REALIGNMENT

**EROSION CONTROL PLAN**  
STA 10+00 TO STA 14+37

SHEET

'As-Built'