


DCT-2003 21-08 39020\Cad\Sheets\apxs01.dgn

NO.	DATE	REVISION	APPROV.	NO.	DATE	REVISION	APPROV.
1	10/10/03	SHEET ISSUED	JSN				



HNTB ARCHITECTS ENGINEERS PLANNERS <small>The HNTB Companies</small>		PROJECT NO. 39020
DESIGN CHECK JSN		
DRAWN CHECK JQH		
DRAWN CHECK GFS		
CHECK JSN		
DATE SEPTEMBER 2003		

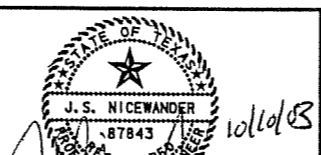

TOWN OF ADDISON	SHEET
AIRPORT PARKWAY REALIGNMENT	
CROSS SECTIONS	

"As-Built"