




11+25

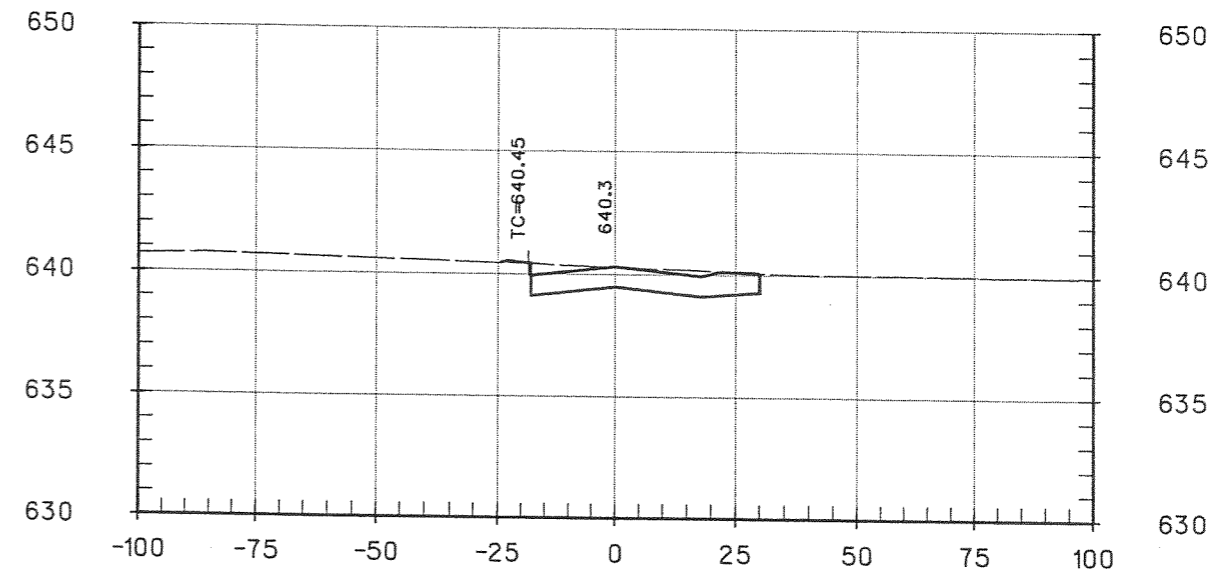

11+75

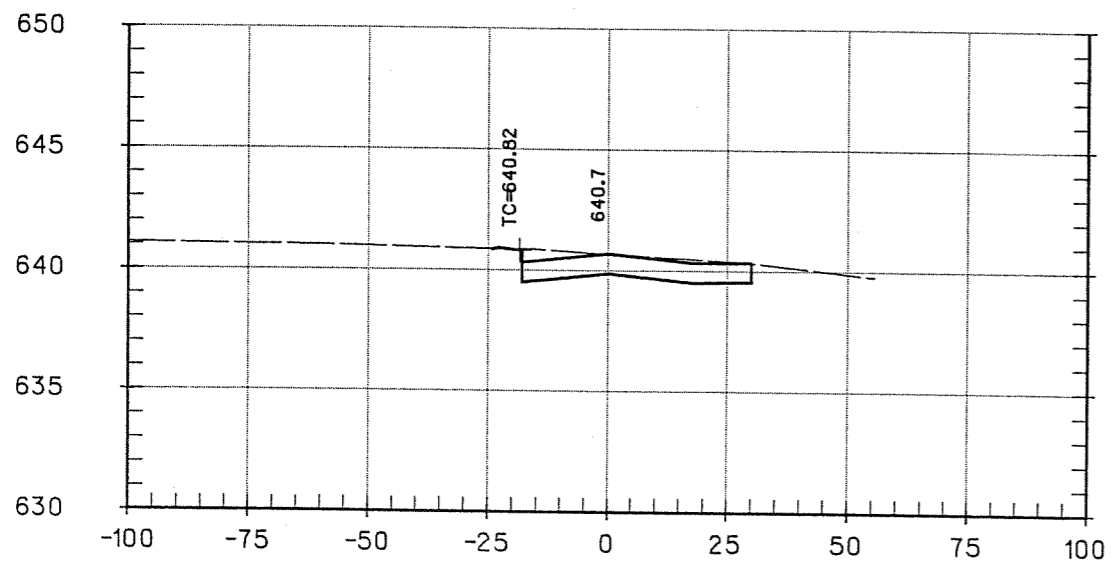


11+00

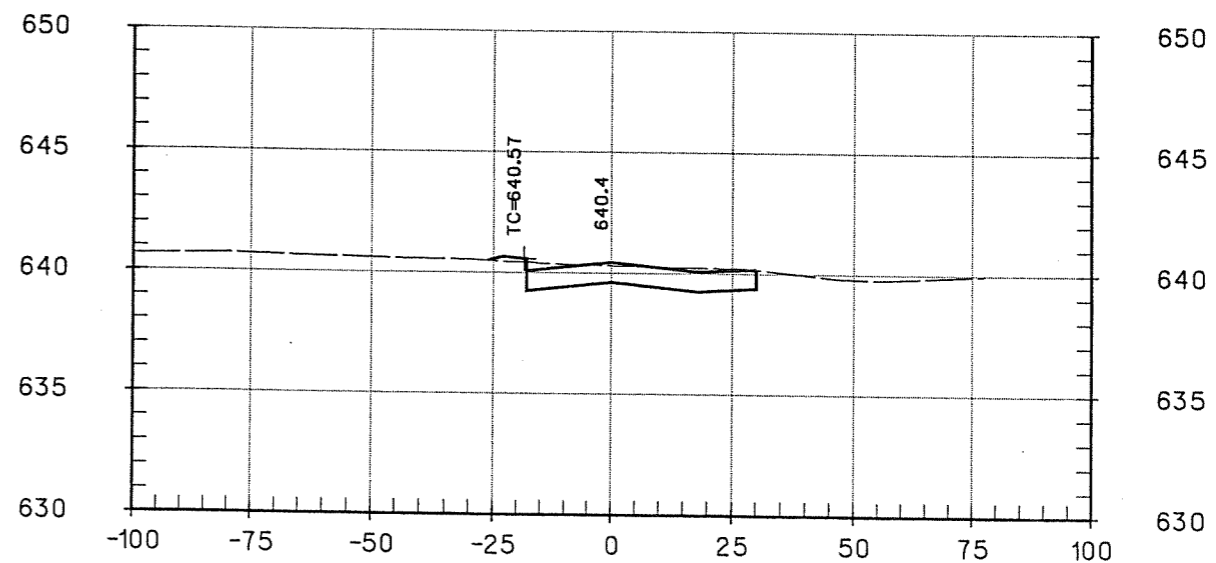

11+50

DCT-2003 21:08 39020\Cad\Sheets\apxs02.dgn

NO.	DATE	REVISION	APPROV.	NO.	DATE	REVISION	APPROV.
1	10/10/03	SHEET ISSUED	JSN				

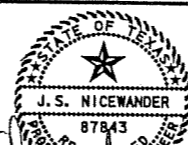

HNTB ARCHITECTS ENGINEERS PLANNERS
The HNTB Companies

DESIGN CHECK: JSN, JDH
DRAWN CHECK: GFS, JSN
DATE: SEPTEMBER 2003

PROJECT NO. 39020



TOWN OF ADDISON
AIRPORT PARKWAY REALIGNMENT

CROSS SECTIONS

"As-Built" SHEET