



14+25

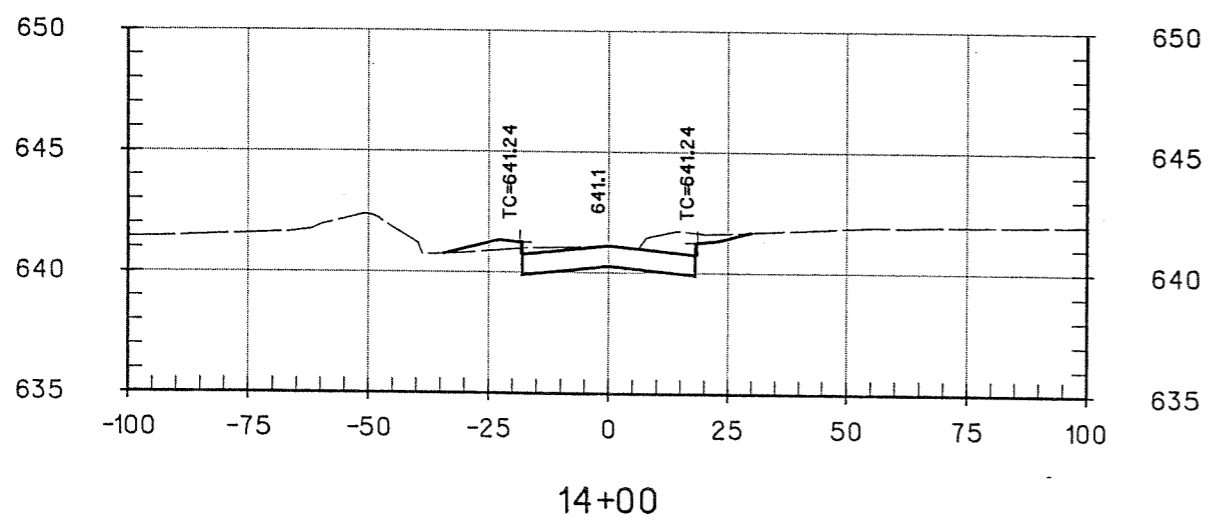

14+00

DCT-2003 21:08 39020\Cadd\Sheets\apxs05.dgn

NO.	DATE	REVISION	APPROV.	NO.	DATE	REVISION	APPROV.
1	10/10/03	SHEET ISSUED	JSN				

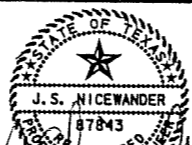

10/10/03

HNTB		ARCHITECTS ENGINEERS PLANNERS <i>The HNTB Companies</i>
DESIGN CHECK	JSN	PROJECT NO. 39020
DRAWN	JDH	
CHECK	GFS	
DATE	JSN	
	SEPTEMBER 2003	



<i>As-Built</i>	
TOWN OF ADDISON	
AIRPORT PARKWAY REALIGNMENT	
CROSS SECTIONS	

SHEET