


CONSTRUCTION PLANS FOR ADDISON AIRPORT WATER MAIN EXTENSION

AN ADDITION TO
THE TOWN OF ADDISON, TEXAS

DEVELOPER


Town of Addison
16801 Westgrove Drive
Addison, Texas 75001
(972) 450-2857
(972) 450-2837 fax
Contact: Clay Barnett, P.E.

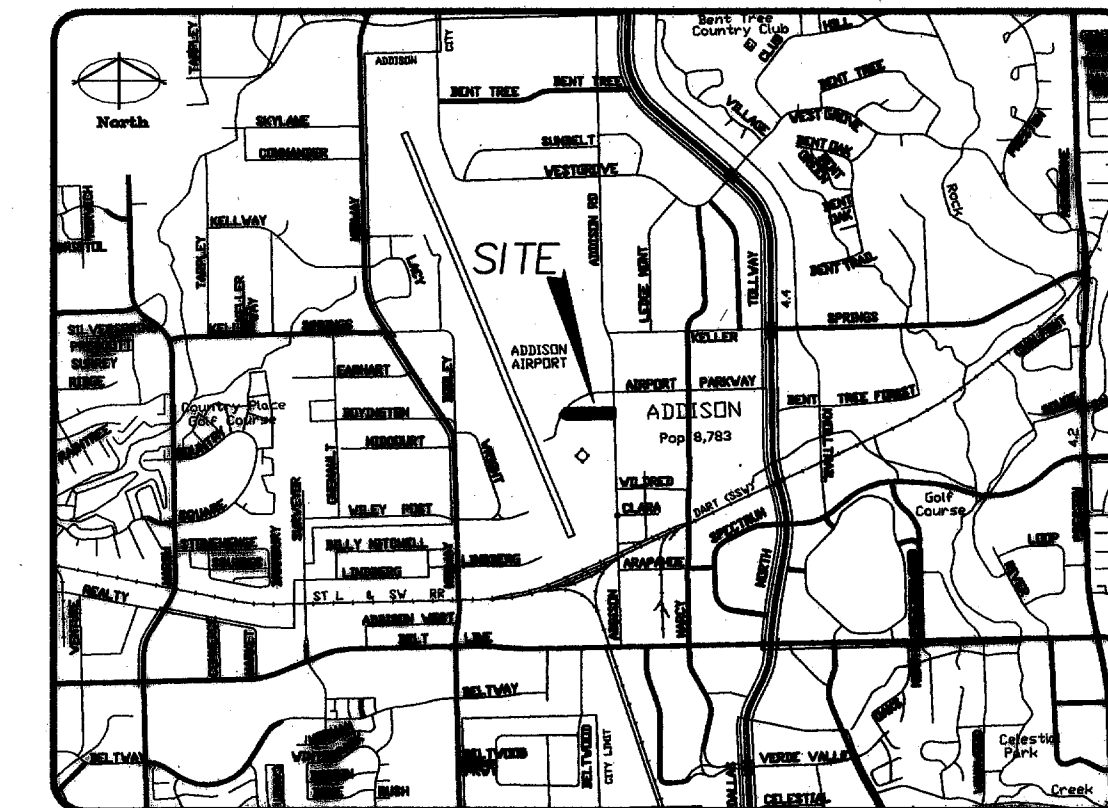

ADDISON
LOCATION MAP
N.T.S.

Civil Engineer/Surveyor

Brockette - Davis - Drake
4144 N. Central Expressway,
Suite 1100
Dallas, Tx. 75204
(214) 824-3647
(214) 824-7064 fax
Contact: Jim Riley, P.E.

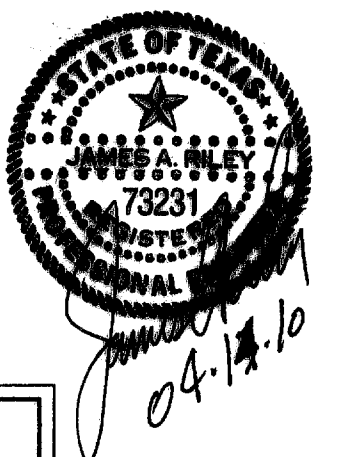

RECORD DRAWING

April 14, 2010

NOTE:
THESE PLANS HAVE BEEN REVISED TO CONFORM
WITH CONSTRUCTION RECORDS PROVIDED BY THE
CONTRACTOR.

C1

B30-5