


NOTE:  
 CONTRACTOR TO VERIFY EXACT  
 LOCATION OF ALL EXISTING UTILITIES  
 BEFORE CONSTRUCTION BEGINS.



GENERAL NOTES

1. All construction will be as per City of Addison Specifications, on file with the Director of Utilities, Addison, Texas.
2. Contractor is to provide 1 year maintenance bond for 10% of the completed construction amount.
3. Encasement pipe shall have a minimum wall thickness of 3/8 inch, and conform to ASTM Spec. A.-34, Mild Steel or A-139, Grade A.
4. Minimum cover shall be 48 inches.
5. Fire hydrants w/valves will be furnished by City. Contractor is to provide all leads and connections necessary to place hydrants.
6. All backfill shall be water jetted until water puddles appear on the surface and all settlement ceases.

AS-BUILT 5-5-82

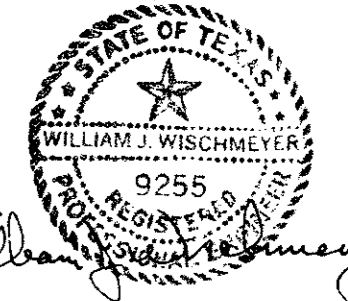

<b>ADDISON MUNICIPAL AIRPORT</b>			
PROPOSED 8" WATERLINE FOR CHAPARRAL AVIATION			
Riewe & Wischmeyer, Inc.		DESIGNED T.K.	
CONSULTING ENGINEERS		DRAWN S.M.	
DALLAS TEXAS		DATE NOV. 1981	
JOB NO. 81-6100	SCALE 1" = 30'	SHEET NO 1 OF 1	

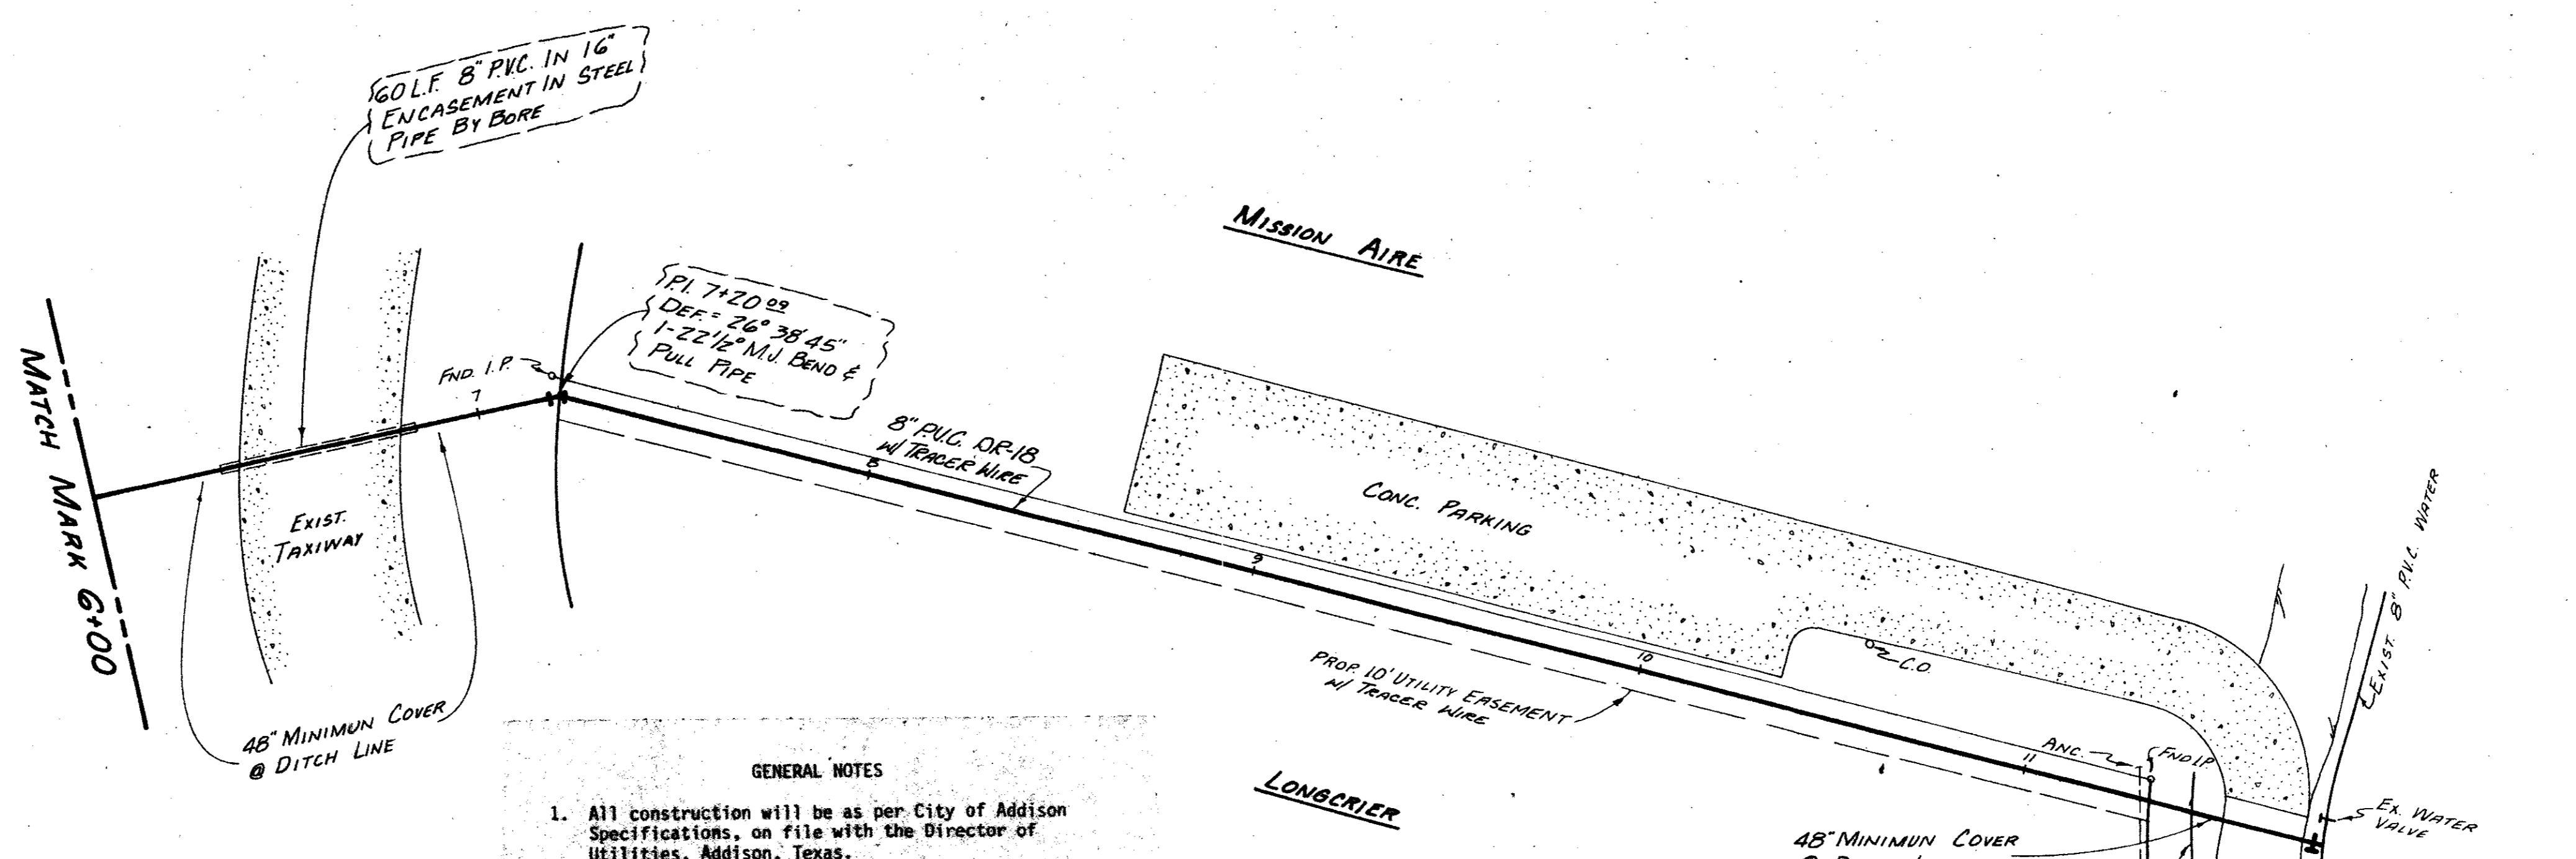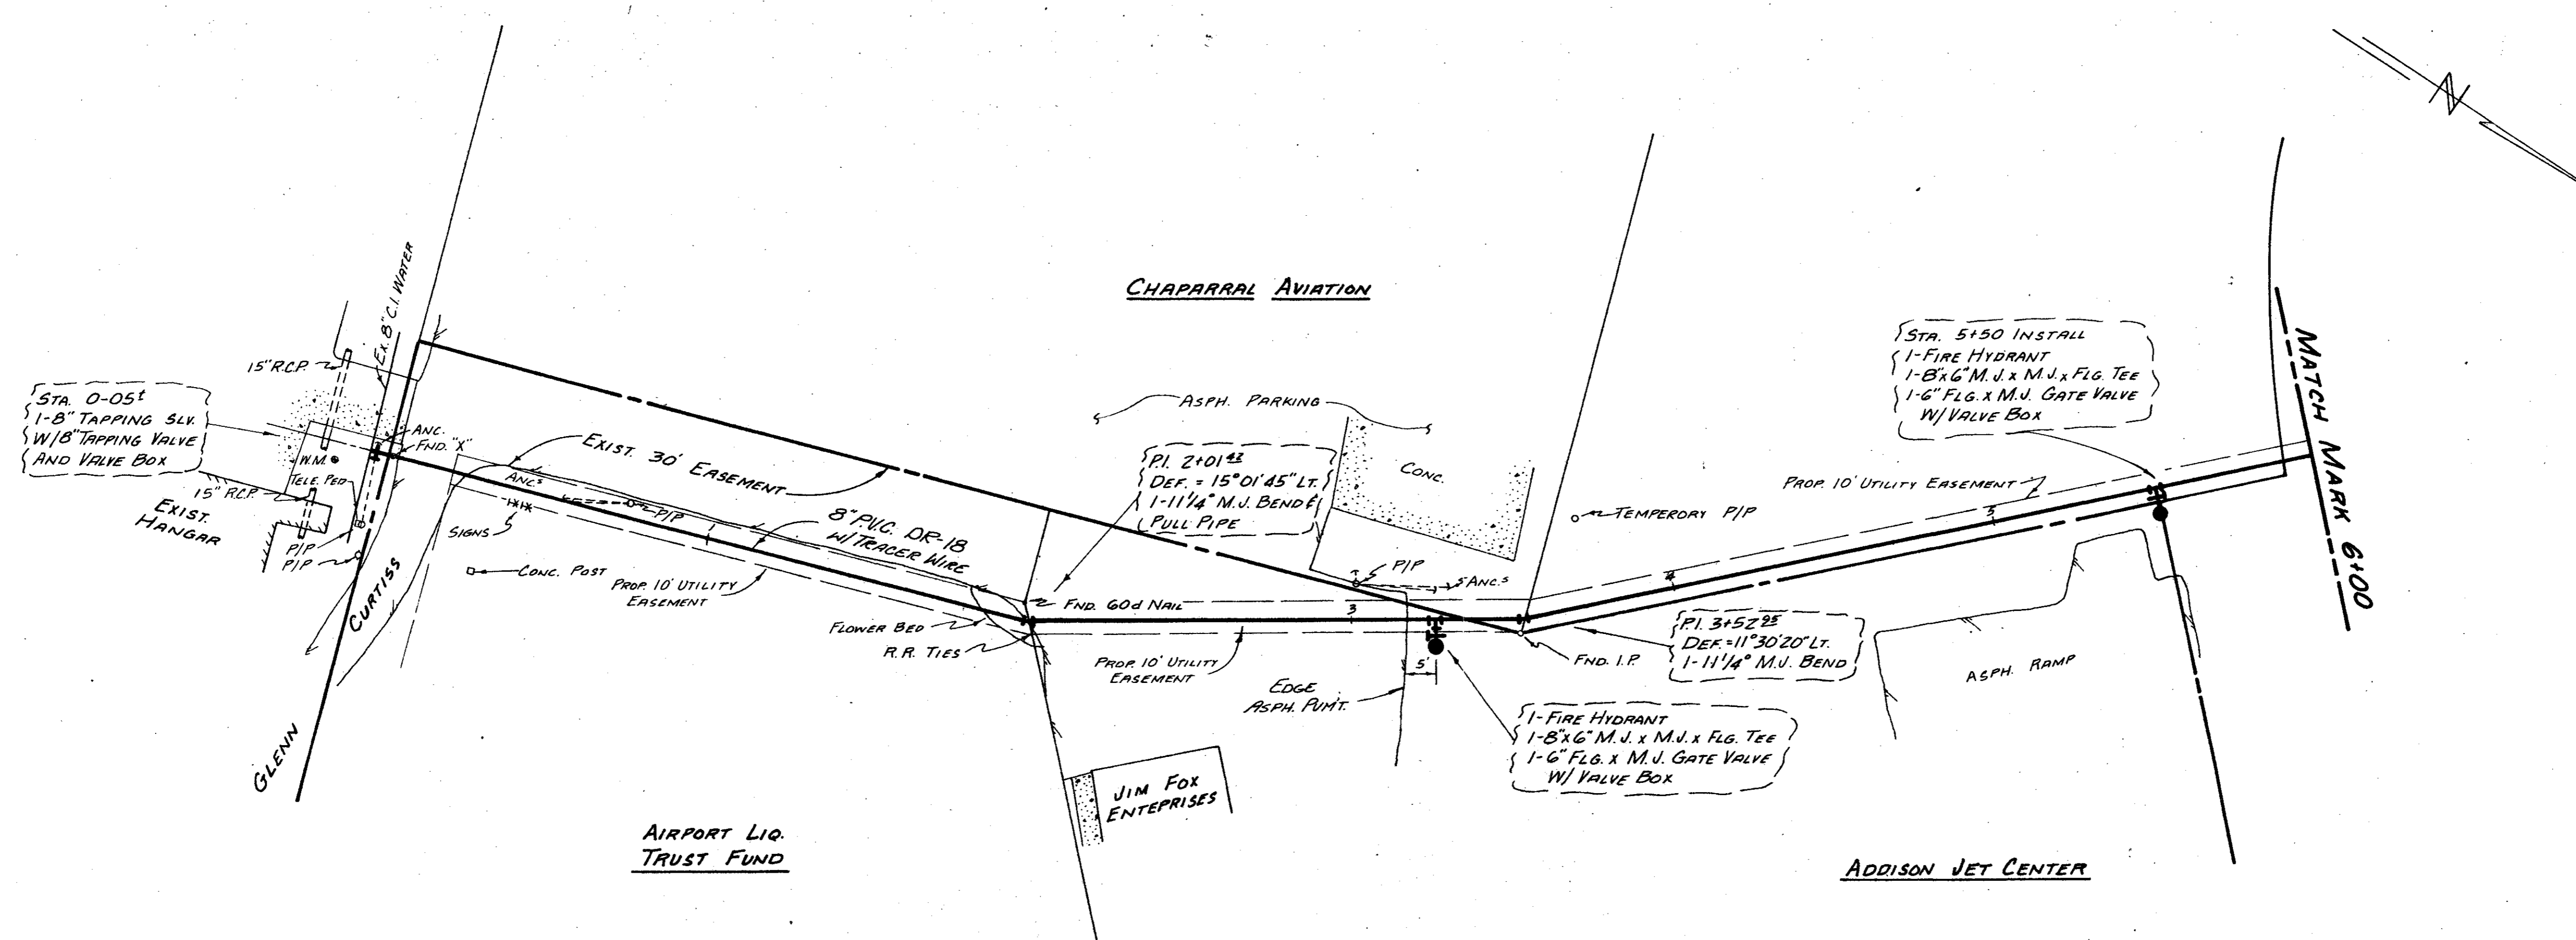

NOTE:  
CONTRACTOR TO VERIFY EXACT  
LOCATION OF ALL EXISTING UTILITIES  
BEFORE CONSTRUCTION BEGINS.

- GENERAL NOTES**
1. All construction will be as per City of Addison Specifications, on file with the Director of Utilities, Addison, Texas.
  2. Contractor is to provide 1 year maintenance bond for 10% of the completed construction amount.
  3. Encasement pipe shall have a minimum wall thickness of 3/8 inch, and conform to ASTM Spec. A-34, Mild Steel or A-139, Grade A.
  4. Minimum cover shall be 48 inches.
  5. Fire hydrants w/valves will be furnished by City. Contractor is to provide all leads and connections necessary to place hydrants.
  6. All backfill shall be water jetted until water puddles appear on the surface and all settlement ceases.

<b>ADDISON MUNICIPAL AIRPORT</b>	
PROPOSED 8" WATERLINE FOR CHAPARRAL AVIATION	
Riewe & Wischmeyer, Inc. CONSULTING ENGINEERS DALLAS, TEXAS	DESIGNED T.K. DRAWN S.M. DATE NOV 1981
JOB NO. 81-6100	SCALE 1" = 30'
SHEET NO. 1 OF 1	

AS-BUILT 5-3-82

WILLIAM J. WISCHMEYER  
REGISTERED PROFESSIONAL ENGINEER  
NO. 9255  
STATE OF TEXAS

10-20-81  
 City of Addison  
 Mission Aire  
 Longbrier  
 10-20-81