


LOCATION MAP

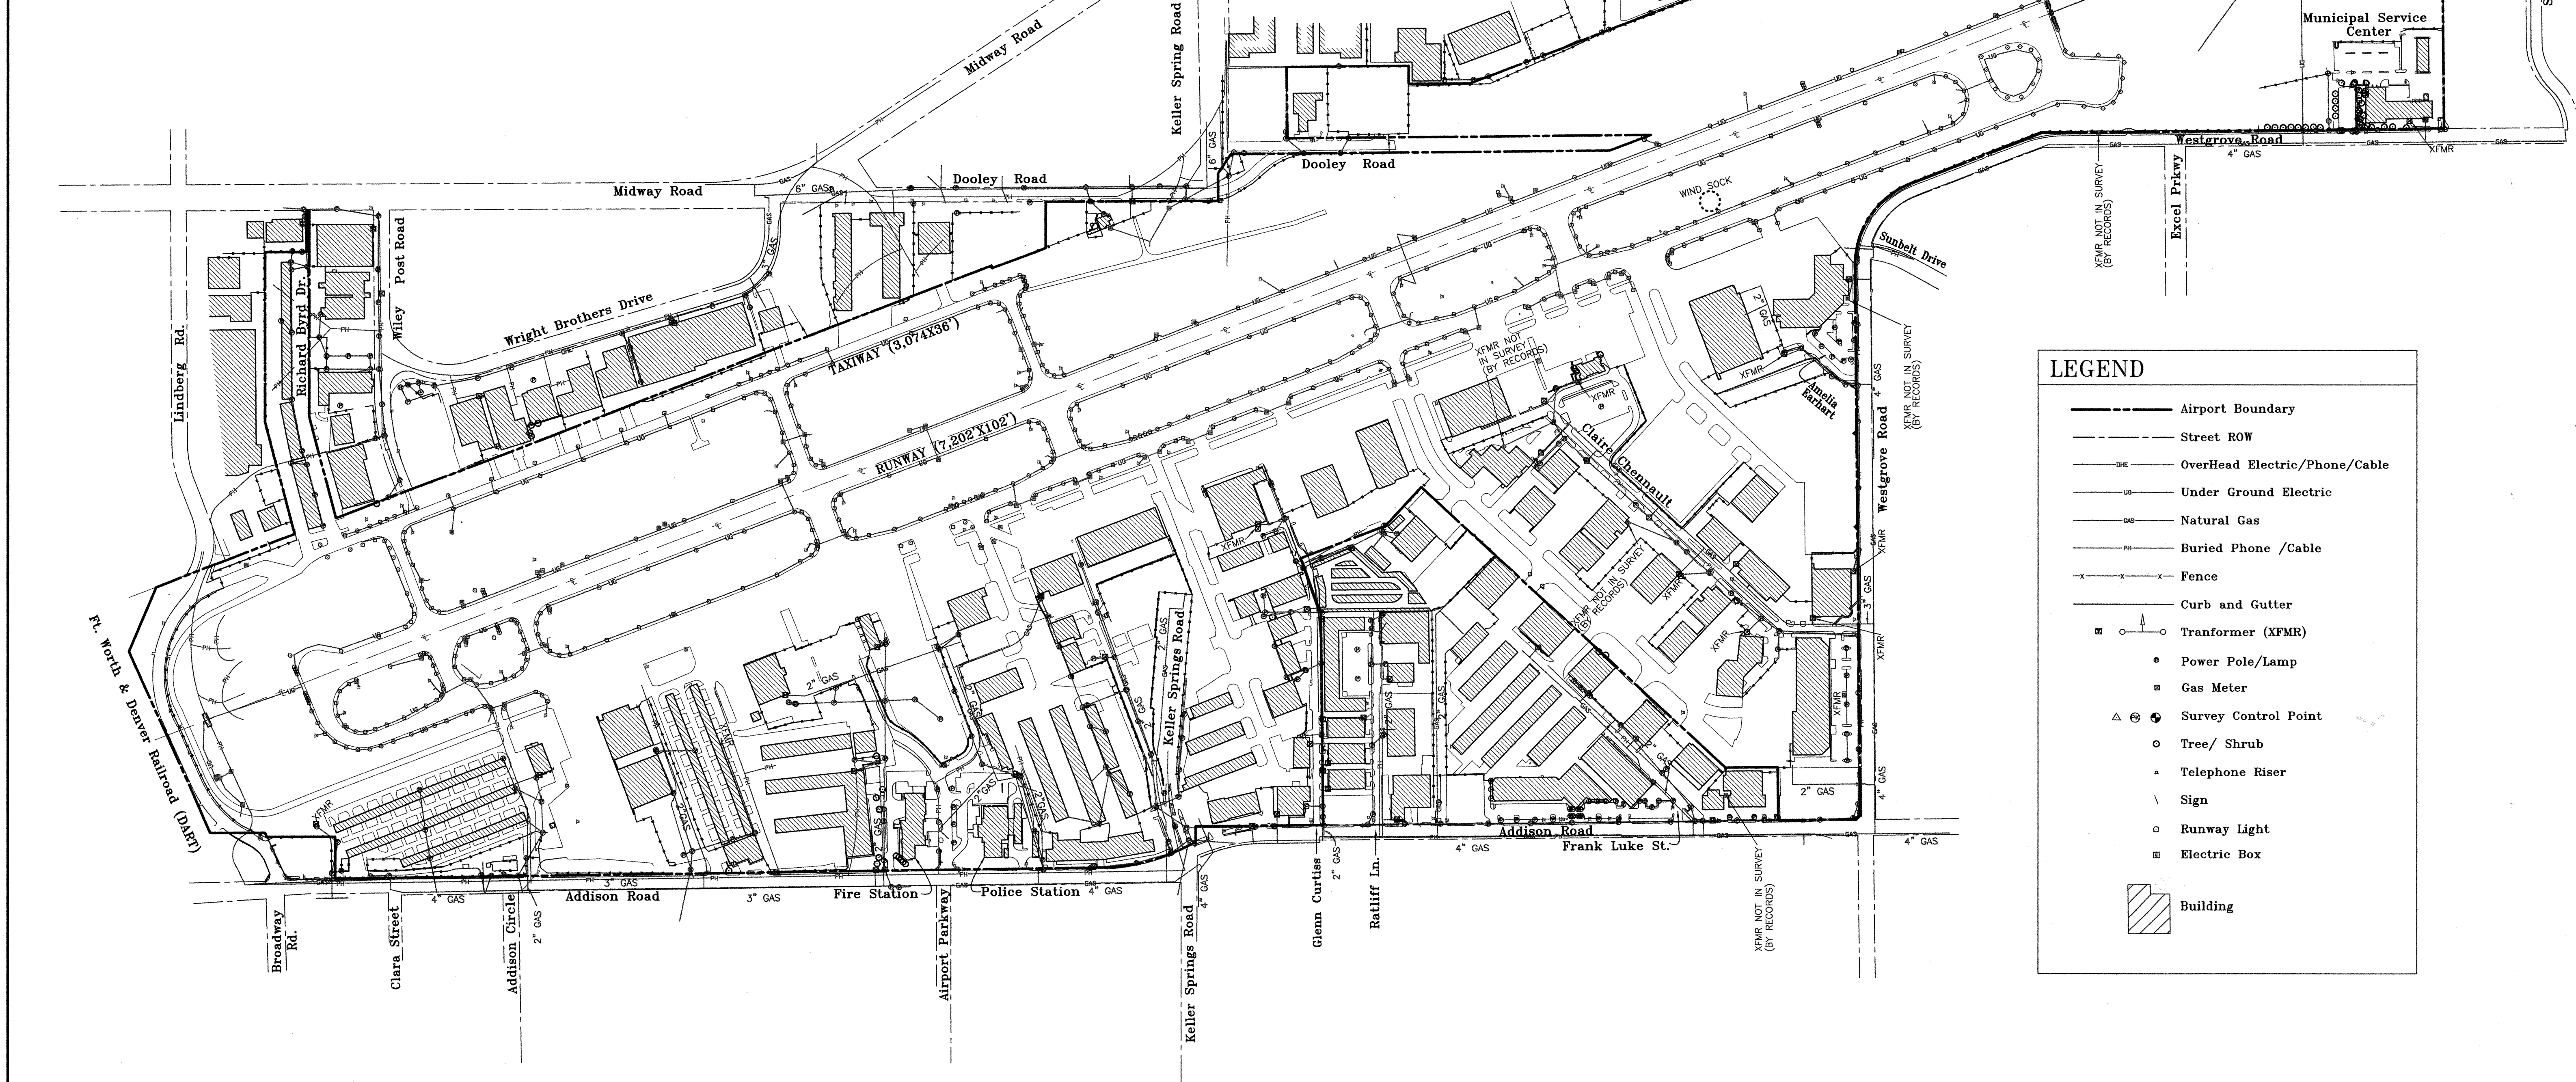

LEGEND

- Airport Boundary
- Street ROW
- OverHead Electric/Phone/Cable
- Under Ground Electric
- Natural Gas
- Buried Phone /Cable
- Fence
- Curb and Gutter
- Transformer (XFMR)
- Power Pole/Lamp
- Gas Meter
- Survey Control Point
- Tree/ Shrub
- Telephone Riser
- Sign
- Runway Light
- Electric Box
- Building

P:\0107\ADDISON\REPORT SURVEY\12-22-01A

DAL-TECH
ENGINEERING, INC.
 CONSULTING CIVIL ENGINEERS / SURVEYORS
 CONSTRUCTION MANAGERS
 17311 DALLAS PARKWAY
 SUITE 200
 DALLAS, TEXAS 75248
 (972) 250-2727 (972) 250-4774

FRANCHISE UTILITIES PLAN
ADDISON AIRPORT
TOWN OF ADDISON, TEXAS

DRAWN	JOB NO.	CONTRACT NO.	SCALE	DATE
DTE	0107	-	1"=300'	01-02-02