

INDEX OF DRAWINGS

SHEET NO.	DESCRIPTION
1	TITLE SHEET AND LOCATION MAP
2	EXISTING AIRPORT LAYOUT PLAN
3	SUMMARY OF QUANTITIES
4	PHASING PLAN
5	PLAN AND PROFILES- LINE 'A'
6	PLAN AND PROFILES- LINE 'B'
7	PLAN AND PROFILES- LINE 'C'
8	PLAN AND PROFILES- LINES 'D' & 'E'
9	PLAN AND PROFILES- LINE 'F'
10	PLAN AND PROFILES- LINES 'G' & 'H'
11	PLAN AND PROFILES- LINES 'G', 'I' & 'J'
12	DRAINAGE AREA MAP
13	STRUCTURE DETAILS S-1, S-2, S-3 AND S-3A
14	STRUCTURE DETAILS S-36A, S-48 AND S-49
15	MISCELLANEOUS DETAILS
16	STRUCTURE DETAILS S-46
17	STRUCTURE DETAILS S-43 & S-45
18 -19	INLET AND GRATE DETAILS (TYPE H)
20	MANHOLE TYPE 'M'
21	CONCRETE HEADWALLS
22	MULTIPLE BOX CULVERTS
23-24	MULTIPLE BOX CULVERTS - 30' SKEW
25	PARALLEL WINGS - NORMAL
26-28	SOILS BORING LOGS
29	UTILITY PLAN
30	FENCING DETAILS




DALLAS COUNTY
STATE OF TEXAS


DRAINAGE IMPROVEMENTS

ADDISON AIRPORT

BID NUMBER 91 - 19
A.I.P. PROJECT NO. 3-48-0063-03-91
SEPTEMBER 1991

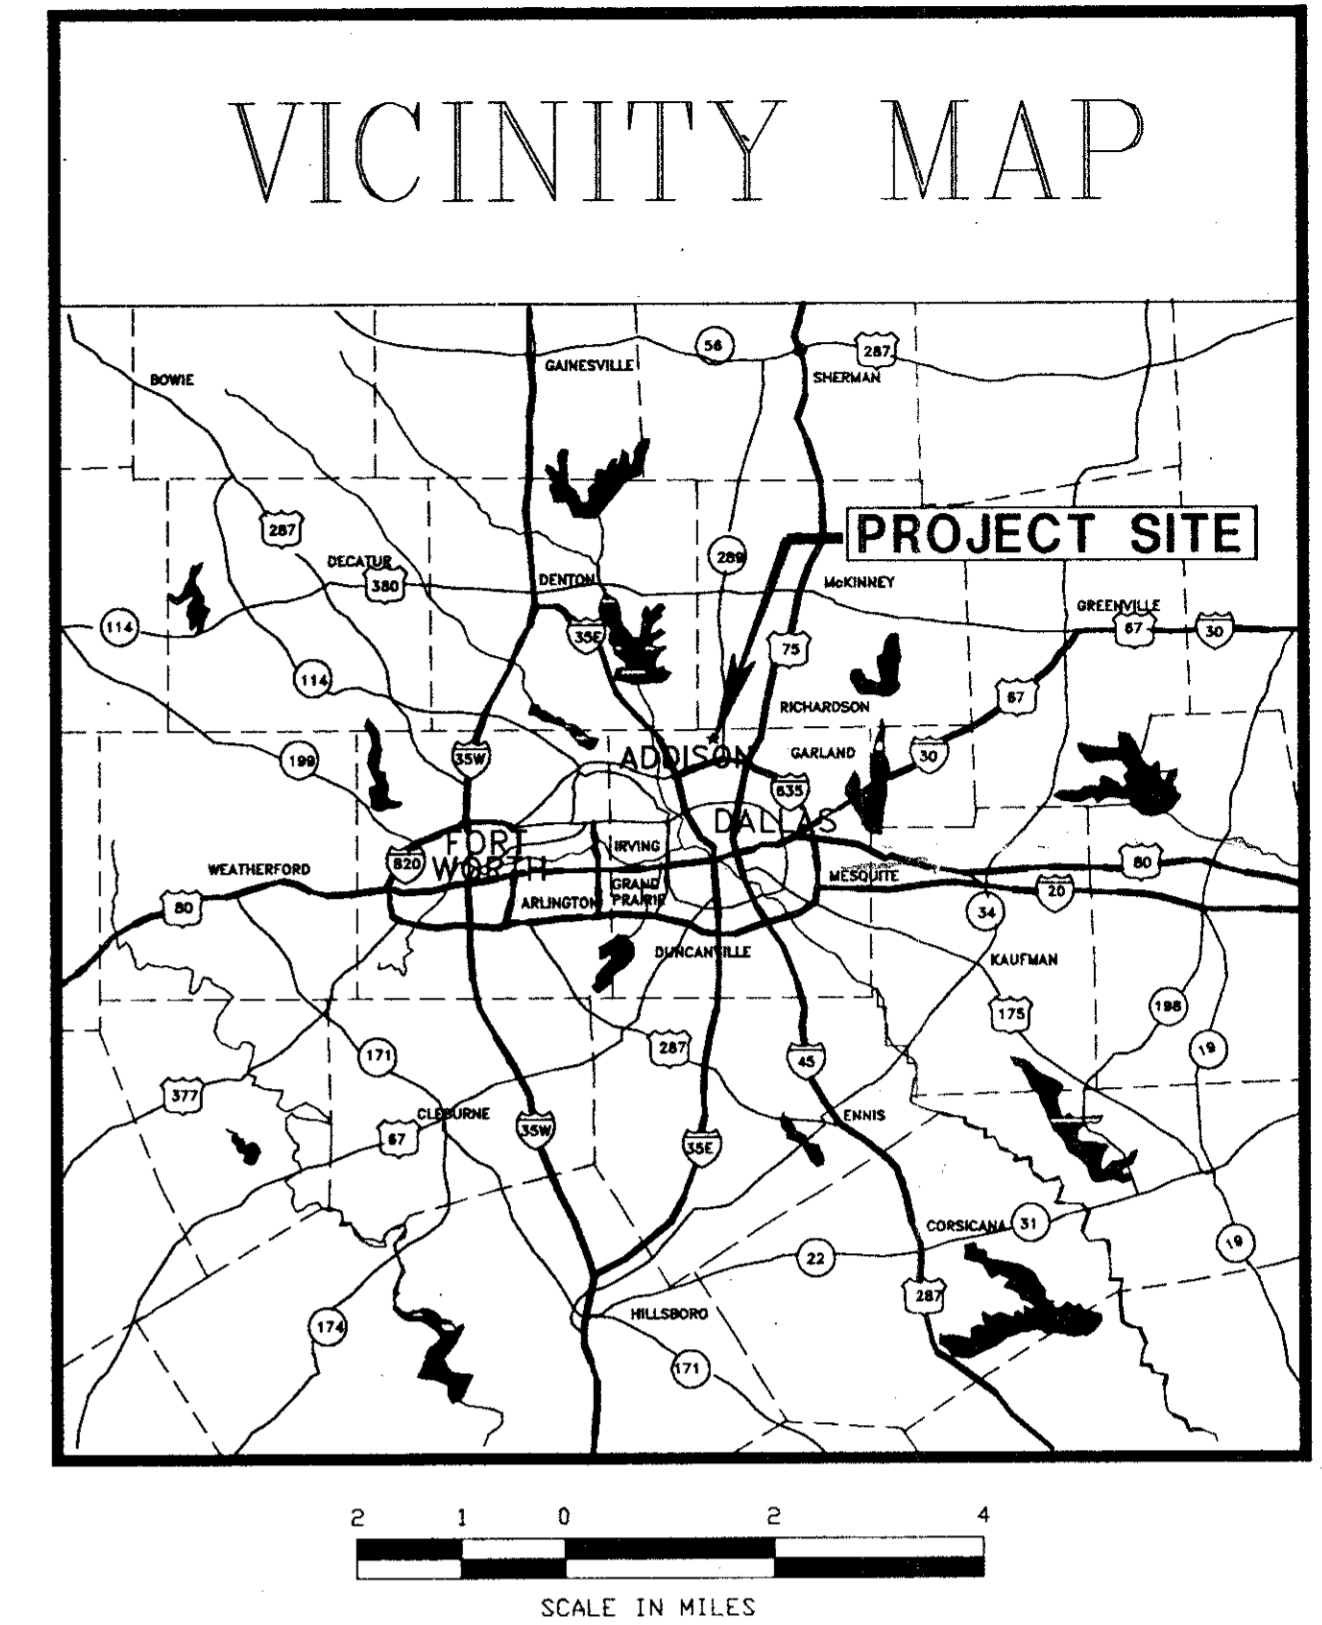

Greiner, Inc.
FORT WORTH, TEXAS
ENGINEERS ARCHITECTS PLANNERS

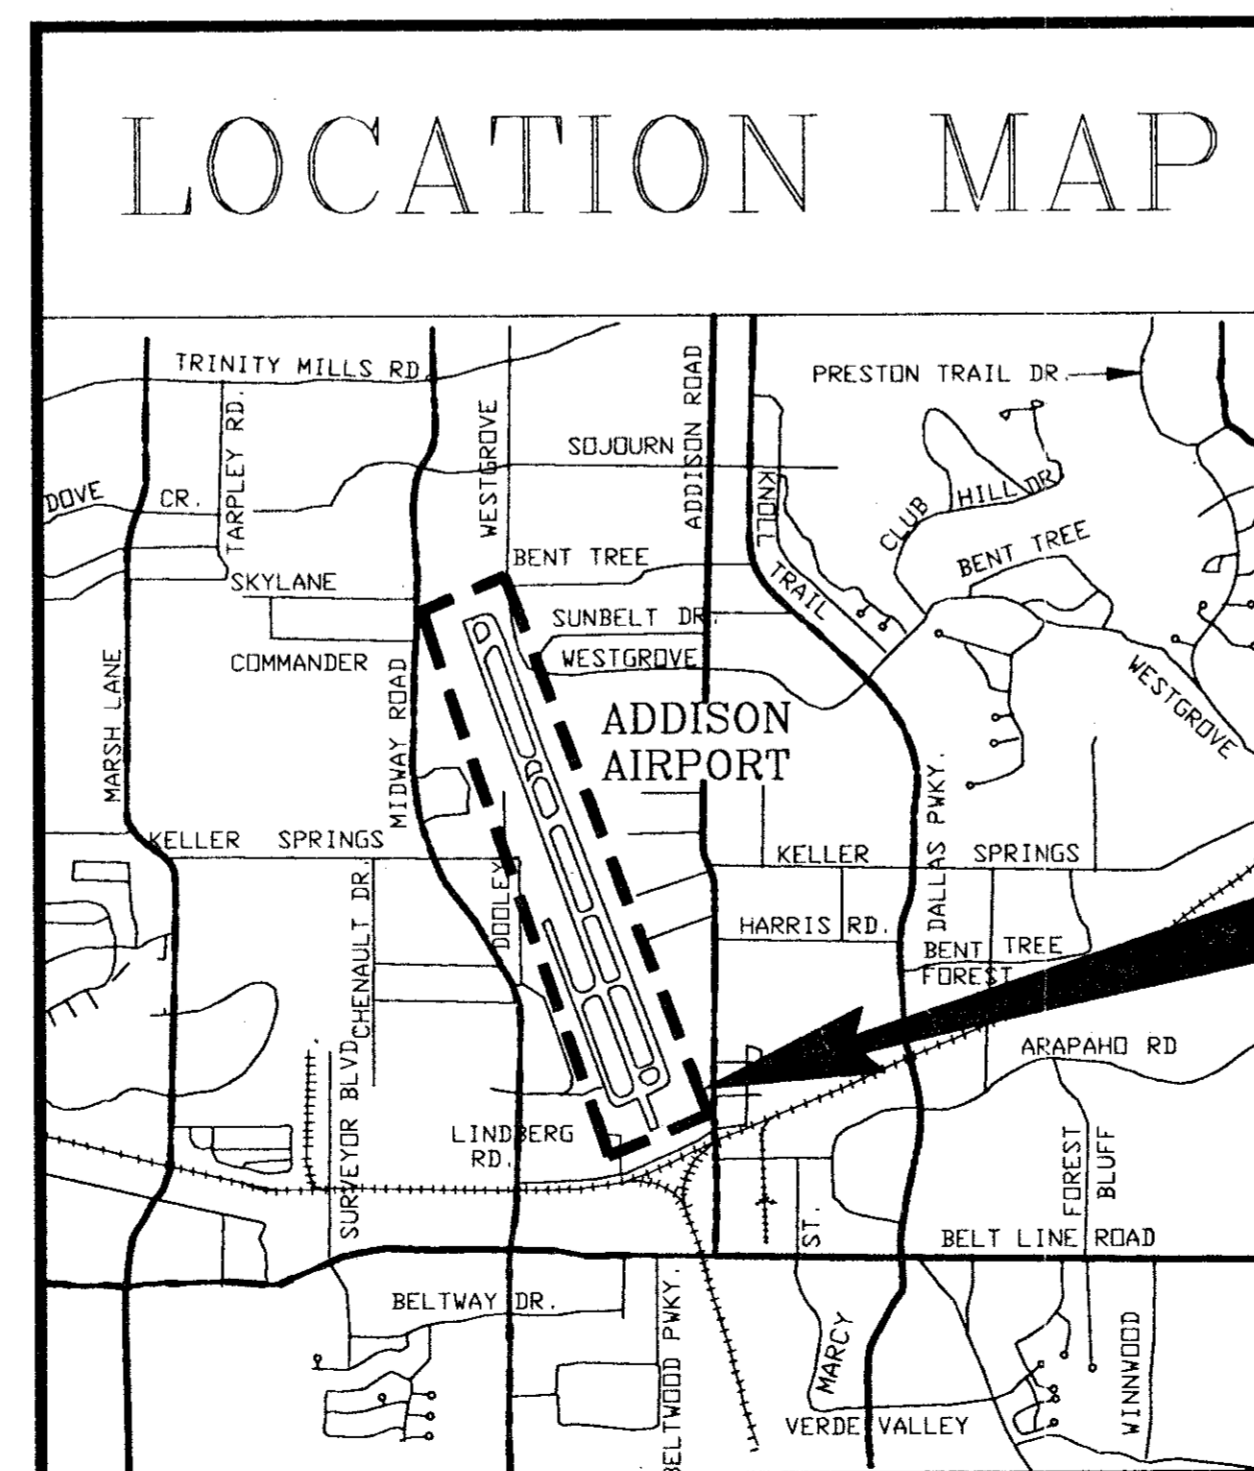

TYPE OF CONSTRUCTION: DRAINAGE, SURFACE GRADING
AND PAVEMENT PATCHING.

REVISIONS		
DATE	DESCRIPTION	BY

RECOMMENDED FOR APPROVAL *Robert C. Greiner*
DESIGN ENGINEER

DATE 8-8-91
RECOMMENDED FOR APPROVAL *John P. Ewing*
PROJECT ENGINEER

DATE 8/8/91
APPROVED *John P. Ewing*
CITY ENGINEER

DATE 3/13/91

AS BUILT
JUL 30 1992

