
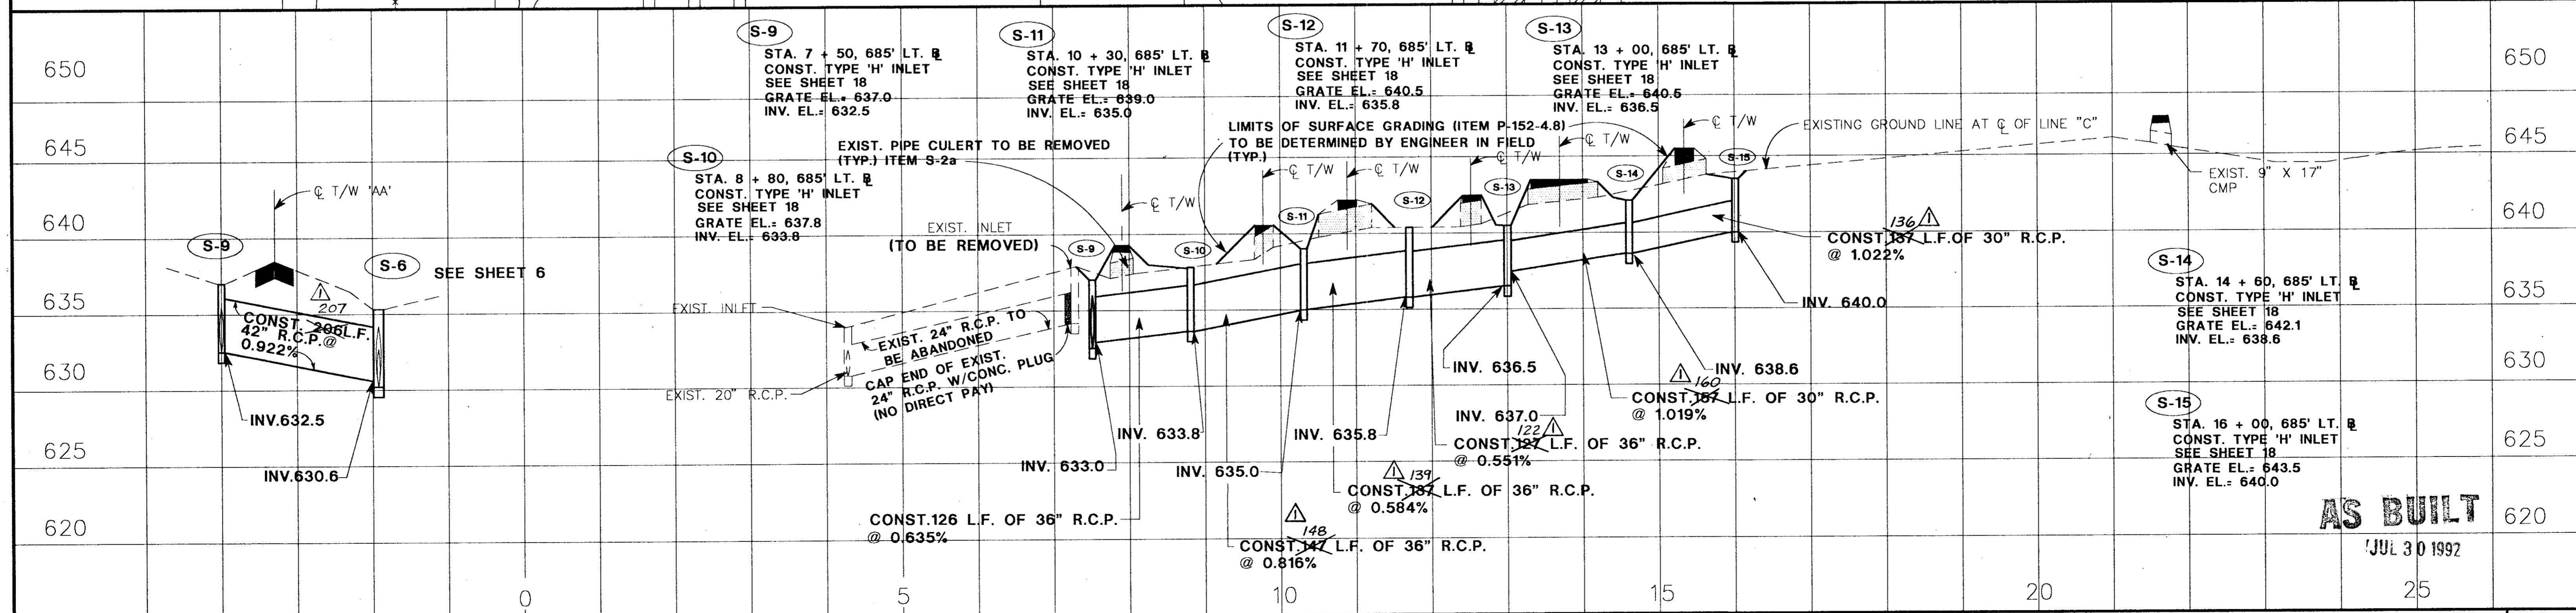


MATCH LINE STA. 25 + 00

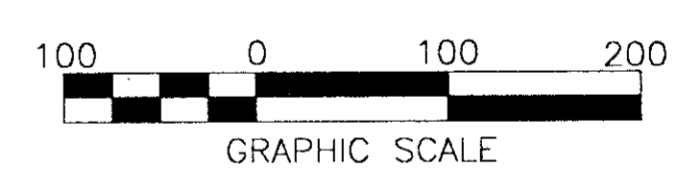

**AS BUILT**  
JUL 30 1992