
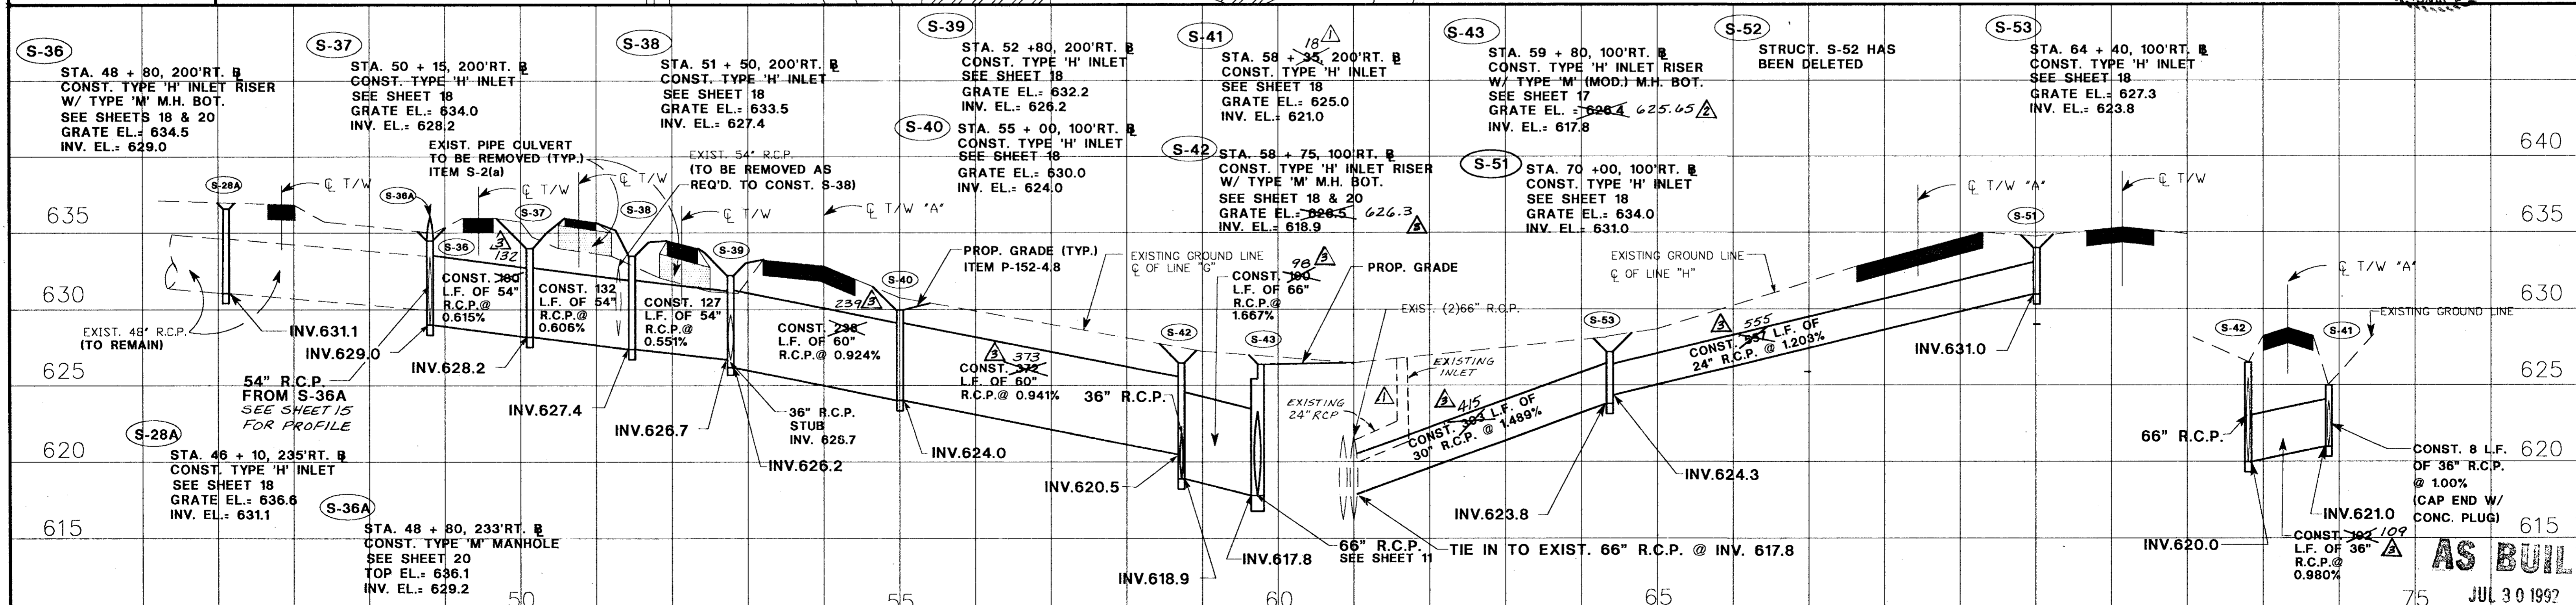


CAUTION UNDERGROUND UTILITIES CONTACT UTILITY COMPANIES FOR LOCATION PRIOR TO CONSTRUCTION ANY DAMAGE TO EXIST. FACILITIES WILL BE THE SOLE RESPONSIBILITY OF THE CONTRACTOR. ANY REPAIRS OR DAMAGES SHALL BE PAID FOR BY THE CONTRACTOR AT NO EXPENSE TO THE OWNER.

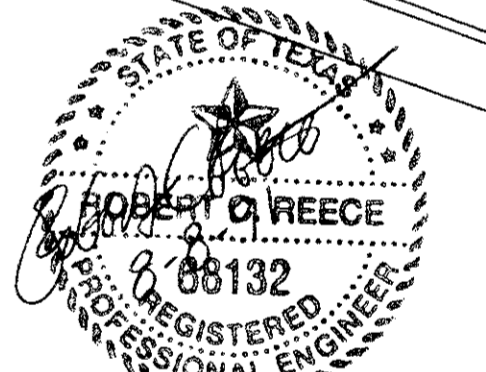

DESIGN: R.C.P.	A.I.P. NO. 3-48-0063-03-91	7-30-92 AS BUILT	JRH
DRAWN: M.J.C.	S.P. NO.	6-1-92 LOWERED S-43 CHANGE ORDER #2	JRH
CHECKED: D.W.P.	JOB NO. Y8024.22	2-3-92 FIELD CHANGE	JRH
SCALE: 1" = 100' HORIZ. 1" = 5' VERT.		Date Revisions	By

Greiner
Greiner, Inc.
Fort Worth, Texas

Engineers, Architects
and Planners



ADDISON AIRPORT

DRAINAGE IMPROVEMENTS
DRAINAGE LINE "G" AND "H"
DRAINAGE PLAN AND PROFILES-STA.46+10 TO STA.70+00

SHEET 10
DATE: SEPT. 1991