
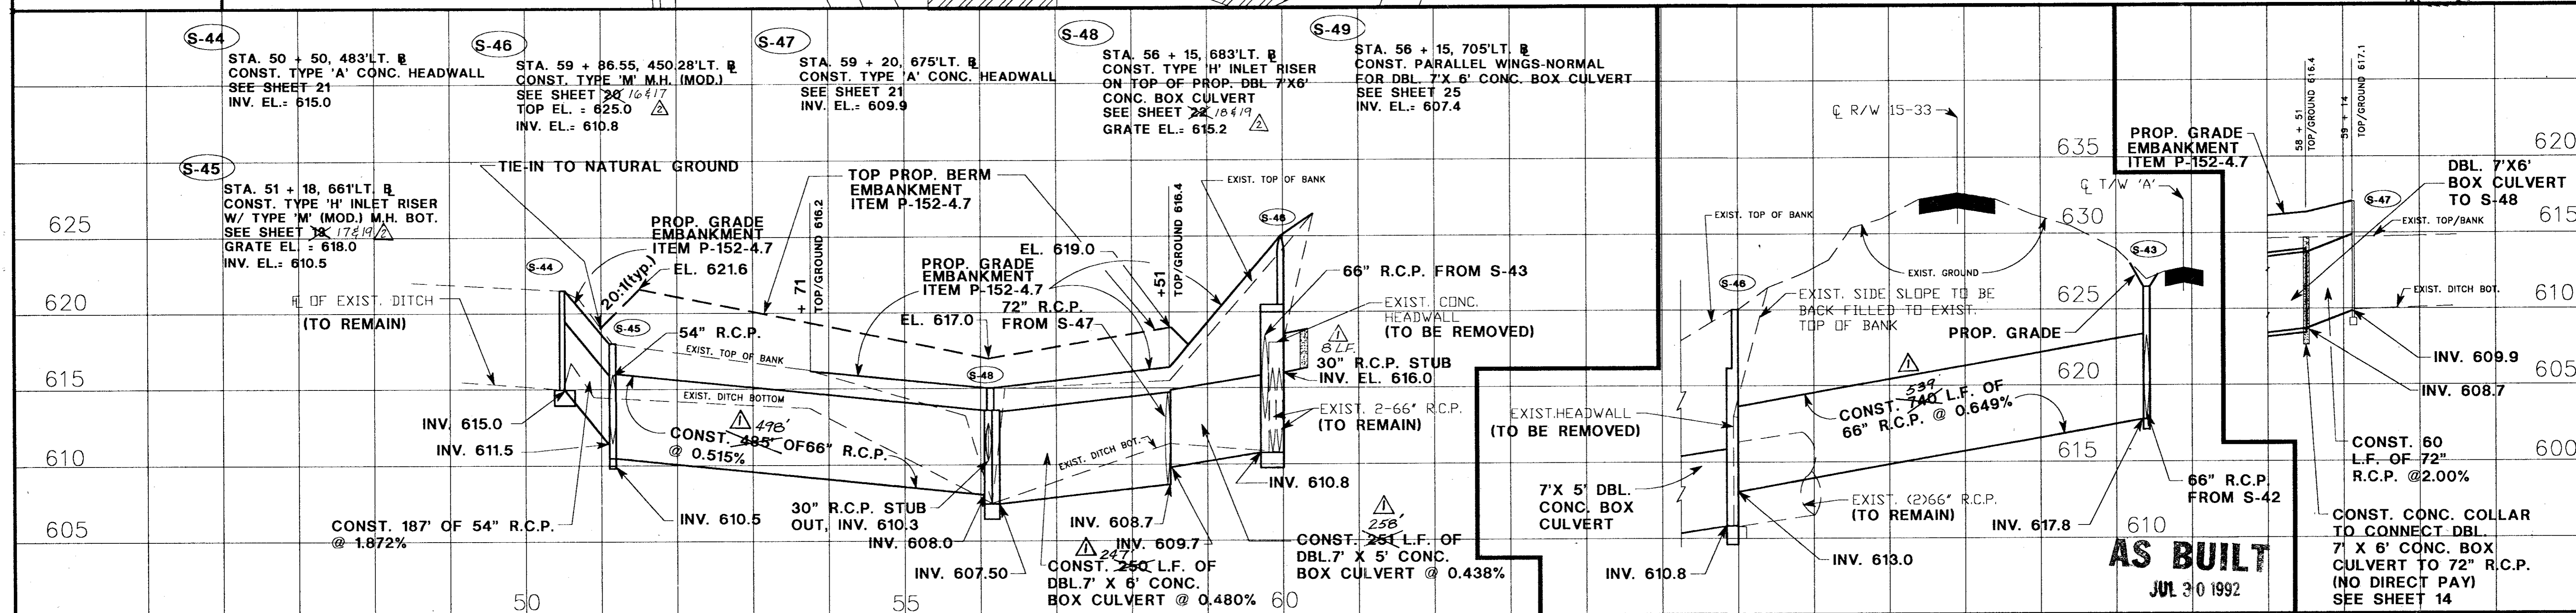


CAUTION UNDERGROUND UTILITIES
CONTACT UTILITY COMPANIES FOR
LOCATION PRIOR TO CONSTRUCTION
ANY DAMAGE TO EXIST. FACILITIES
WILL BE THE SOLE RESPONSIBILITY
OF THE CONTRACTOR. ANY REPAIRS
OR DAMAGES SHALL BE PAID FOR BY
THE CONTRACTOR AT NO EXPENSE TO
THE OWNER.

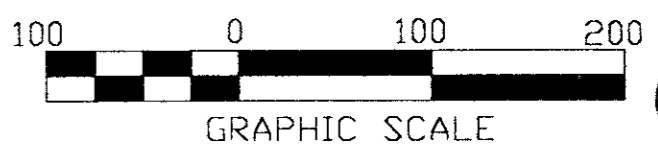

AS BUILT
JUL 30 1992