



RUNWAY 33 RSA IMPROVEMENTS (EMAS)

TOWN OF ADDISON ADDISON AIRPORT ADDISON, TEXAS

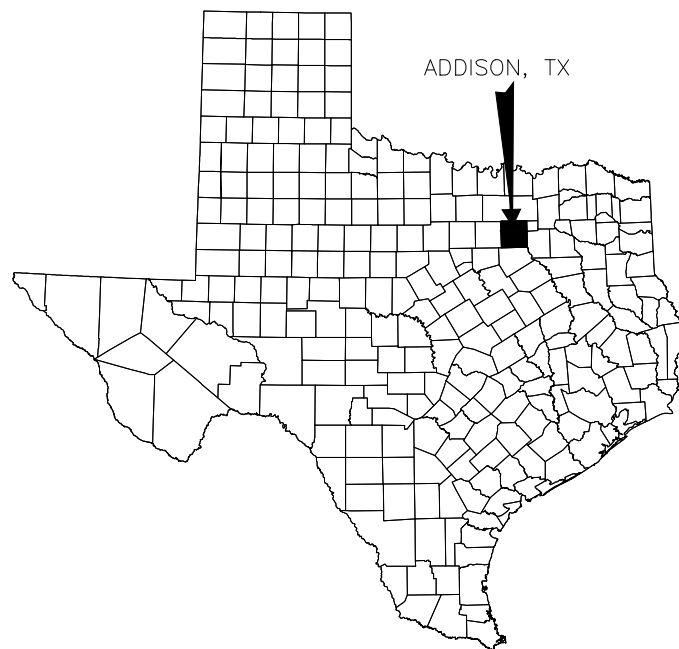

LOCATION MAP

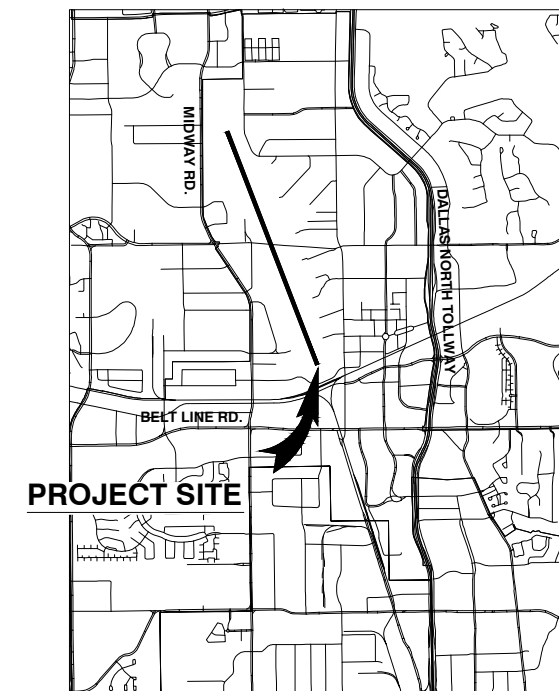

VICINITY MAP

NO SCALE

TxDOT CSJ NO. 1318ADDSN
GARVER PROJECT NO. 13081100
TX ENGINEERING REGISTRATION NO. F-5713
NOVEMBER, 2013



3010 Gaylord Parkway
Suite 190
Frisco, TX 75034
(972) 377-7480

RECORD DRAWINGS
03/10/2015

To the best knowledge of the Engineer, these drawings have been generally conformed to the construction of the improvements based on information supplied by the owner, contractor and/or resident project representative. The accuracy of the information contained within these record drawings is not guaranteed.

Mitchell R. Canall
MITCHELL R. MCANALL P.E.
03-10-2015
Date



REGISTRATION NO.
F-5713

RECORD DRAWINGS
03/10/2015

REV.	DATE	DESCRIPTION	BY



ADDISON AIRPORT
ADDISON, TEXAS

RUNWAY 33 RSA IMPROVEMENTS

COVER SHEET

JOB NO.: 13081100
DATE: NOV. , 2013
DESIGNED BY: BCB
DRAWN BY: MLM

BAR IS ONE INCH ON ORIGINAL DRAWING
0 1"
IF NOT ONE INCH ON THIS SHEET, ADJUST SCALES ACCORDINGLY.

DRAWING NUMBER
G-101

SHEET NUMBER
1