
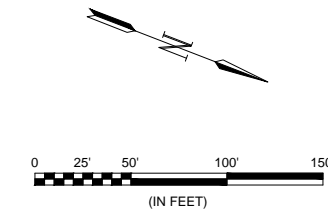


File: I:\2014\14081101 - ads emas construction\Drawings\RECORD\ADS\_EMAS\_G202\_SC.dwg Last Save: 10/15/2014 1:40 PM Last saved by: Scjohanson  
 Last plotted by: Suarez, Javier Plot Style: AECmonochrome.ctb Plot Date: 3/10/2015 4:39 PM Plotter used: DWG To PDF.pc3

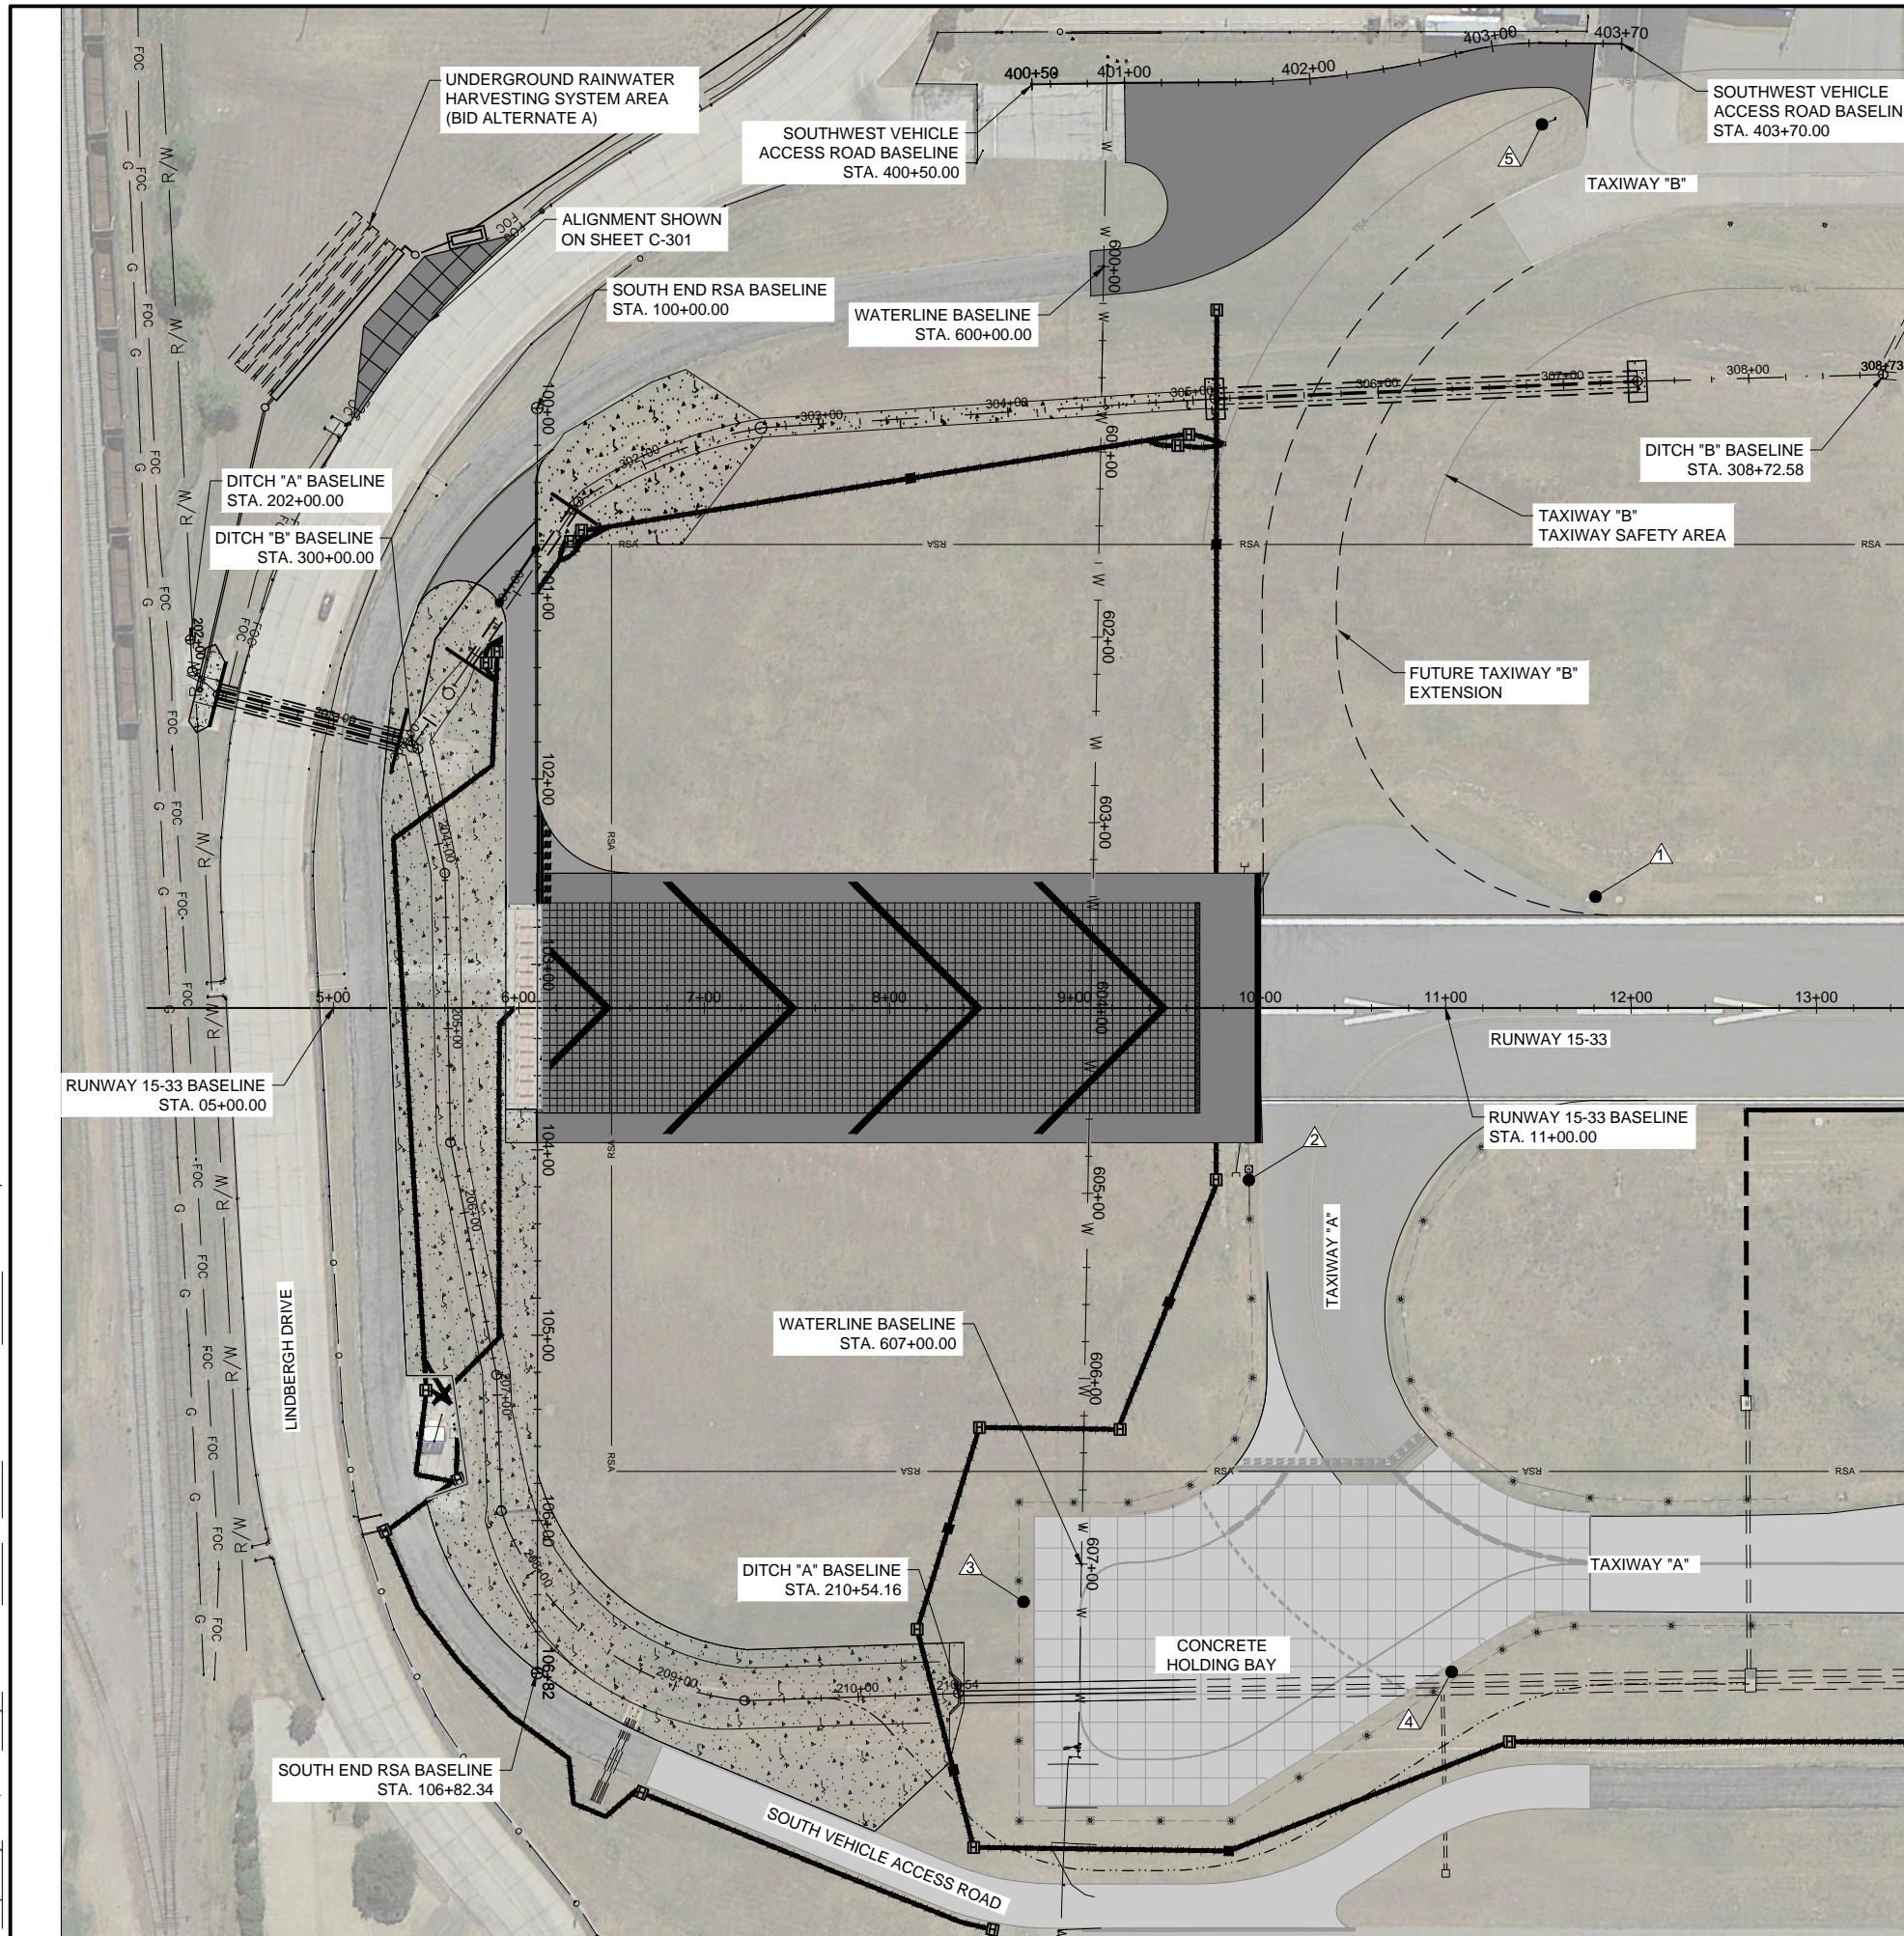

LEGEND	
	SURVEY CONTROL POINT

TAXIWAY "B" SURVEY CONTROL POINTS				
POINT NO.	NORTHING	EASTING	ELEVATION	DESCRIPTION
1	7037095.64	2480161.31	635.67	NAIL SET
2	7036976.35	2480371.26	634.47	NAIL SET
3	7036944.97	2480627.41	631.69	NAIL SET
4	7037174.05	2480579.36	633.03	NAIL SET
5	7036918.51	2479783.18	632.10	GPS MON

BASELINE POINTS						
DESCRIPTION	STATION	NORTHING	EASTING	RADIUS	LENGTH	DELTA
<b>RUNWAY 15-33 (CROSS SECTION ALIGNMENT)</b>						
POB	5+00.00	7036482.21	2480462.81			
POE	11+00.00	7037041.85	2480246.48			
<b>DITCH "A"</b>						
POB	202+00.00	7036338.60	2480305.48			
PI	202+17.04	7036345.83	2480320.93			
PI	202+35.90	7036363.50	2480327.51			
PI	203+35.90	7036462.82	2480315.89			
PI	203+47.55	7036474.47	2480316.05			
PI	204+16.06	7036512.12	2480373.28			
PI	205+61.55	7036567.42	2480507.86			
PI	206+89.23	7036635.77	2480615.73			
PC	207+62.83	7036664.64	2480683.40			
PI	208+62.03	7036728.69	2480759.15	152.50'	175.89'	66°04'58.2"L
PT	209+38.72	7036823.90	2480731.32			
POE	210+54.16	7036930.14	2480686.18			
<b>DITCH "B"</b>						
POB	300+00.00	7036471.28	2480315.94			
PI	301+54.49	7036506.19	2480165.45			
PC	301+59.49	7036507.17	2480160.55			
PI	302+13.01	7036537.99	2480115.78	250.00'	107.03'	24°31'46.2"R
PT	302+66.52	7036584.60	2480087.84			
PI	305+11.84	7036807.31	2479984.96			
PI	307+40.00	7037016.54	2479893.98			
POE	308+72.58	7037138.78	2479842.65			
<b>WATERLINE</b>						
POB	600+00.00	7036725.61	2479939.94			
POE	607+00.00	7036966.79	2480597.09			
<b>SOUTHWEST VEHICLE ACCESS ROAD (CROSS SECTION ALIGNMENT)</b>						
POB	400+50.00	7036653.99	2479862.28			
PI	401+00.00	7036700.33	2479843.51			
PC	401+62.80	7036758.80	2479820.60			
PI	402+23.22	7036814.96	2479762.81	500.00'	120.26'	13°46'51.1"L
PRC	402+83.06	7036863.93	2479762.81			
PI	403+04.51	7036881.36	2479750.29	162.00'	42.65'	15°05'08.7"R
PT	403+25.71	7036901.43	2479742.74			
POE	403+70.00	7036942.89	2479727.16			
<b>SOUTH END RSA (CROSS SECTION ALIGNMENT)</b>						
POB	100+00.00	7036468.18	2480121.48			
POE	106+82.34	7036714.22	2480757.91			



REGISTRATION NO. F-5713

RECORD DRAWINGS  
03/10/2015

REV.	DATE	DESCRIPTION	BY

ADDISON AIRPORT  
ADDISON, TEXAS  
RUNWAY 33 RSA IMPROVEMENTS

SURVEY CONTROL PLAN

JOB NO.: 13081100  
DATE: NOV., 2013  
DESIGNED BY: BCB  
DRAWN BY: BCB

BAR IS ONE INCH ON ORIGINAL DRAWING  
IF NOT ONE INCH ON THIS SHEET, ADJUST SCALES ACCORDINGLY.

DRAWING NUMBER  
**G-202**

SHEET NUMBER  
**5**