


LOW PROFILE AIRCRAFT BARRICADE (MOVEMENT AREAS)


SCALE: NONE

NOTES:

- BARRICADES SHALL MEET THE REQUIREMENTS OF THE CURRENT FAA ADVISORY CIRCULAR 150/5370-2 AND BE APPROVED BY THE ENGINEER
- CONTRACTOR SHALL WEIGHT BARRICADE TO PREVENT DISPLACEMENT.
 THE METHOD SHALL BE APPROVED BY THE ENGINEER.
- BARRICADES SHALL BE LOCATED AS DEFINED IN THE CONSTRUCTION SAFETY AND PHASING PLAN (CSPP).
- BARRICADES SHALL BE PLACED ALONG THE EDGE OF EXISTING PAVEMENT.

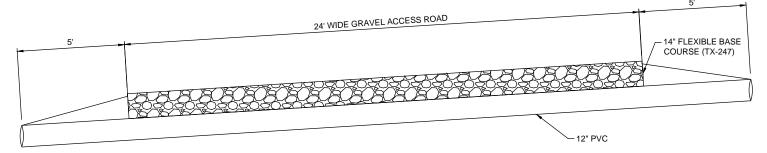

G-202 TEMPORARY GRAVEL ROAD 3 SCALE: NONE

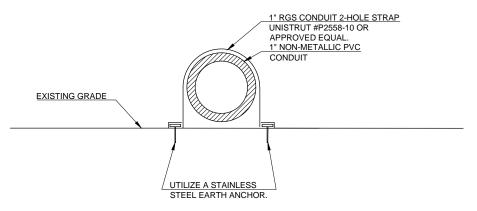

G-202 4


ABOVE GROUND TEMPORARY CONDUIT SUPPORT


SCALE: NONE

SUPPORT NOTES:

. PLACE NON-METALLIC PVC CONDUIT NEXT TO BARRICADES WHEN CROSSING PAVED AREAS.

CONDUIT WILL NOT HAVE TO BE ANCHORED IN PAVEMENT UNLESS OTHERWISE SPECIFIED BY THE ENGINEER.

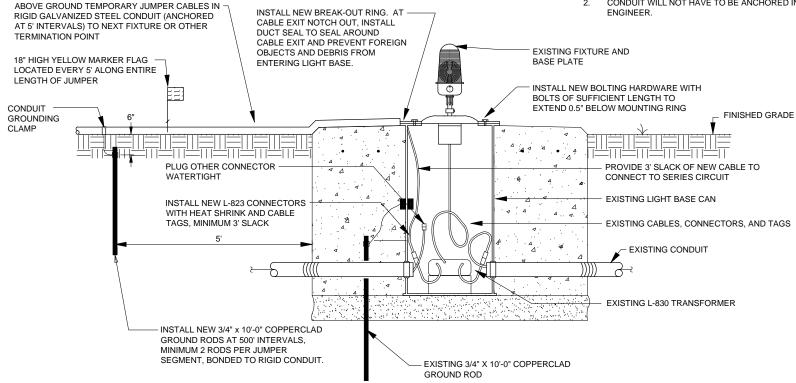

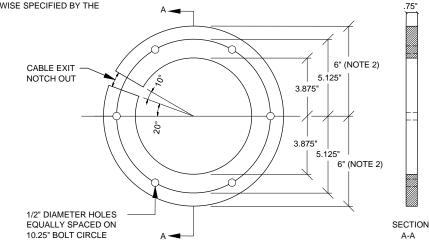

G-202 B 5 SC

BREAK OUT RING

SCALE: NONE

BREAK OUT RING NOTES:

- HOLE PATTERN SHALL MATCH EXISTING BASE CAN. PATTERN SHOWN IS FOR 12" L-867B CAN.
- U. OUTSIDE DIMENSION SHALL MATCH EXISTING CAN.
- BREAK-OUT RING SHALL BE FABRICATED FROM 3/4" MARINE GRADE A PLYWOOD WITH 10 MIL POLYURETHANE FINISH APPLIED AFTER TEMPORARY CABLE IS INSTALLED.
- BREAK-OUT RINGS, ABOVE GROUND CONDUIT, JUMPER CABLES, LUMBER, SUPPORTS, HARDWARE, AND OTHER APPURTENANCES ARE INCIDENTAL TO THE TEMPORARY AIRFIELD LIGHTING PAY ITEM. CONTRACTOR SHALL SUPPLY SUFFICIENT QUANTITY TO SUPPORT RE-WIRING ACTIVITIES.



REGISTRATION NO F-5713

RECORD DRAWINGS
03/10/2015

REV. DATE DESCRIPTION BY

Addison!

33

ADDISON AIRPORT ADDISON, TEXAS

SAFETY & PHASING DETAILS

JOB NO.: 13081100 DATE: NOV., 2013 DESIGNED BY: MRM DRAWN BY: MRM

BAR IS ONE INCH CORIGINAL DRAWIN

THIS SHEET, ADJUST SCALES ACCORDINGLY.

DRAWING NUMBER

G-203

EET MBER 6

14414081101 - ads emas construction\Drawings\RECRD\ADS_EMAS_G203_TC.dwg <u>Last Save:</u> 10/15/2014 1:40 PM <u>Last s</u> ted by: Suarez Javier Plot Sivie: AECmono.ctb Plot Scale: 1:1 Plot Daie: 3/10/2015 4:39 PM Plotter used: DWG To PDE pos

G-202

2 SCA

TEMPORARY JUMPER CIRCUIT CONNECTION

SCALE: NONE