



--- EXISTING CONTOURS (6" INCREMENTS)  
 - - - FINAL CONTOURS

A = 12' 15' 23"  
 R = 365.00  
 T = 39.18'  
 L = 78.08'

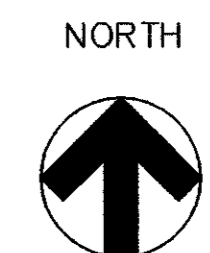

Scale 1" = 30'

FOR MORE INFO REFER TO:  
 BOUNDARY SURVEY  
 3.518 ACRES by  
 RIEWE & WISCHMEYER, INC.  
 CONSULTING ENGINEERS  
 DALLAS, TEXAS

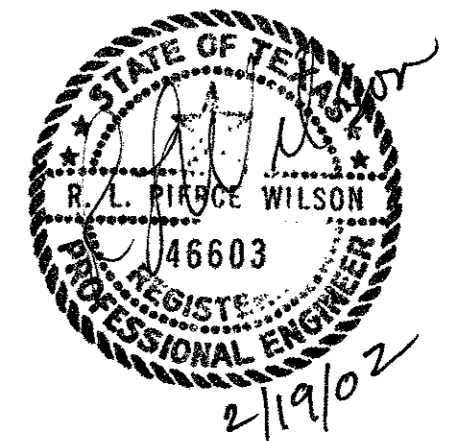

ADDISON EXPRESS  
 HANGER ADDITION  
 4500 Claire Chennault  
 Addison, Texas

PLAN VIEW  
 CONTOURS & DRAINAGE PLAN

WECO ENGINEERING CO  
 406 Erie Street  
 Cleburne, Texas 76031  
 (817) 645-1160

REV.	DATE	DESCRIPTION

DWG NO. addison2

G-2

DATE: 05-27-00