



LOCATION MAP

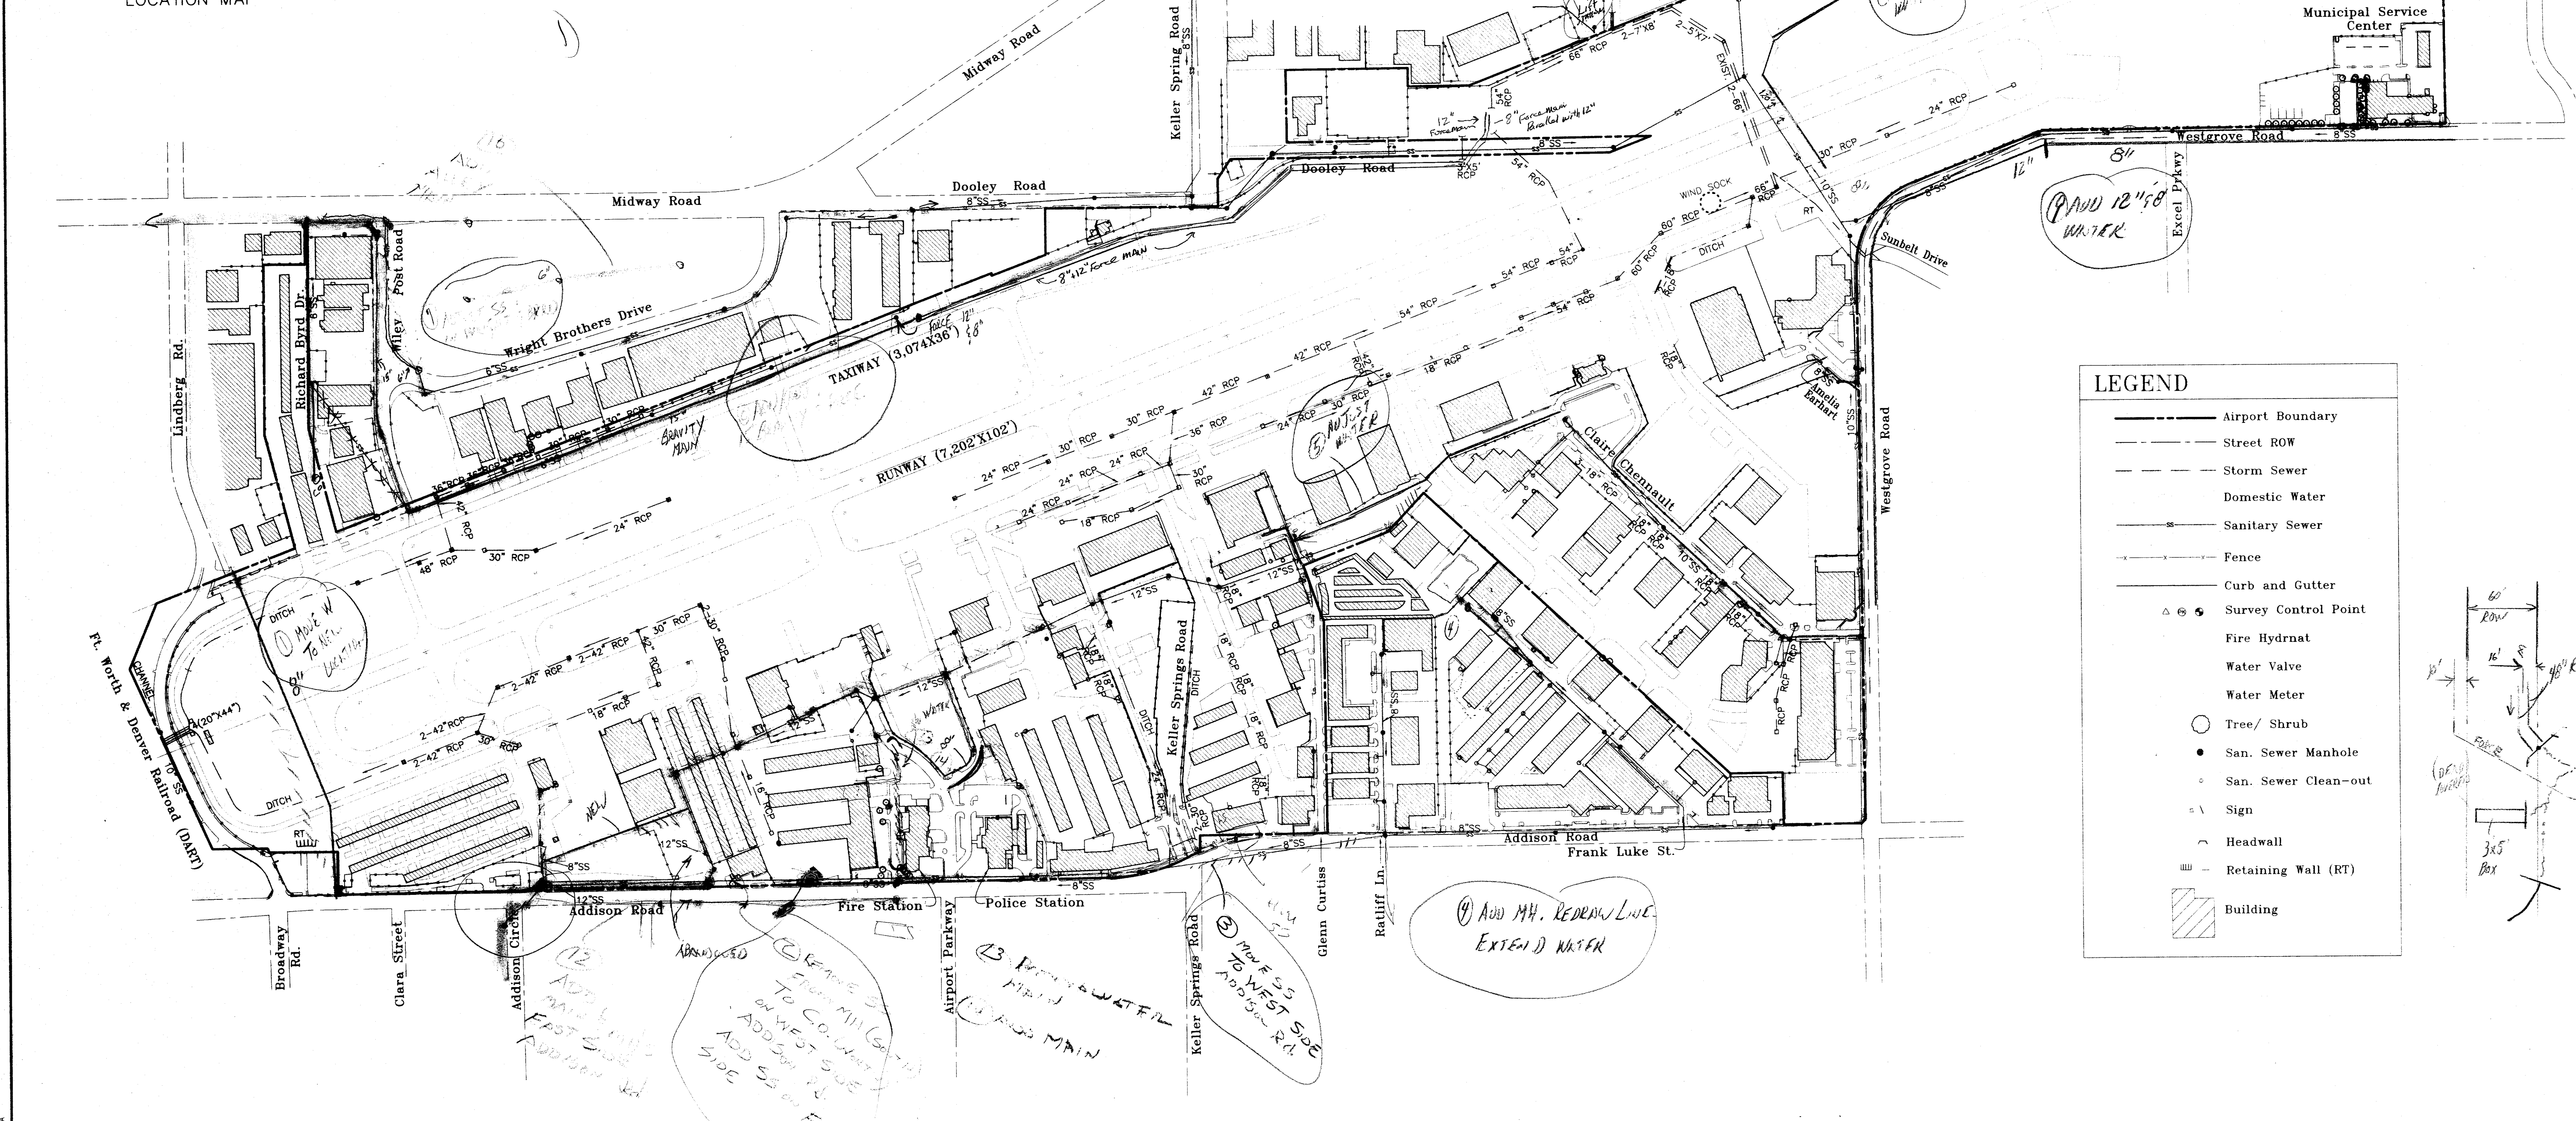

**LEGEND**

- Airport Boundary
- - - Street ROW
- - - Storm Sewer
- - - Domestic Water
- - - Sanitary Sewer
- - - Fence
- - - Curb and Gutter
- △ Survey Control Point
- Fire Hydrant
- Water Valve
- Water Meter
- Tree/ Shrub
- San. Sewer Manhole
- San. Sewer Clean-out
- △ Sign
- Headwall
- ▬ Retaining Wall (RT)
- ▨ Building

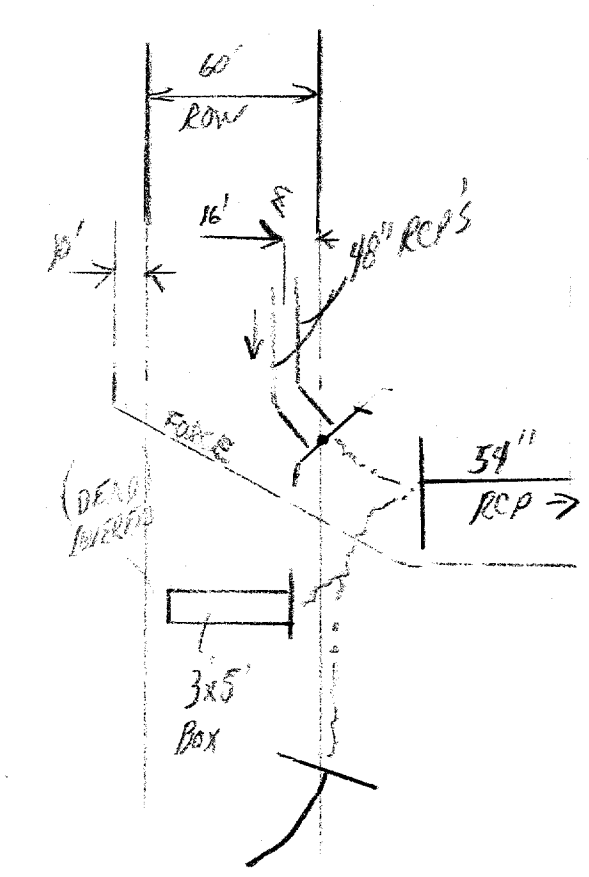

(15) COMPLETE MAIN TO PUMP STA

(6) ADD MAIN W/ RT  
(7) ADD 12" 58" WATER

(4) ADD MH. REDRAW LINE EXTEND WATER

(12) ADD MAIN TO WEST SIDE ADDISON RD  
(13) ADD MAIN TO WEST SIDE ADDISON RD  
(14) ADD MAIN TO WEST SIDE ADDISON RD

P:\07\ADDISONAIRPORT\SURVEY\12-22-01A

**DAL-TECH ENGINEERING, INC.**  
 CONSULTING CIVIL ENGINEERS / SURVEYORS  
 CONSTRUCTION MANAGERS  
 17311 DALLAS PARKWAY  
 SUITE 200  
 DALLAS, TEXAS 75248  
 (972) 250-2727 (972) 250-4774

**CITY UTILITIES PLAN  
 ADDISON AIRPORT  
 TOWN OF ADDISON, TEXAS**

DRAWN	JOB NO.	CONTRACT NO.	SCALE	DATE
DTE	0107	-	1" = 300'	01-02-02