


4745 FRANK LUKE

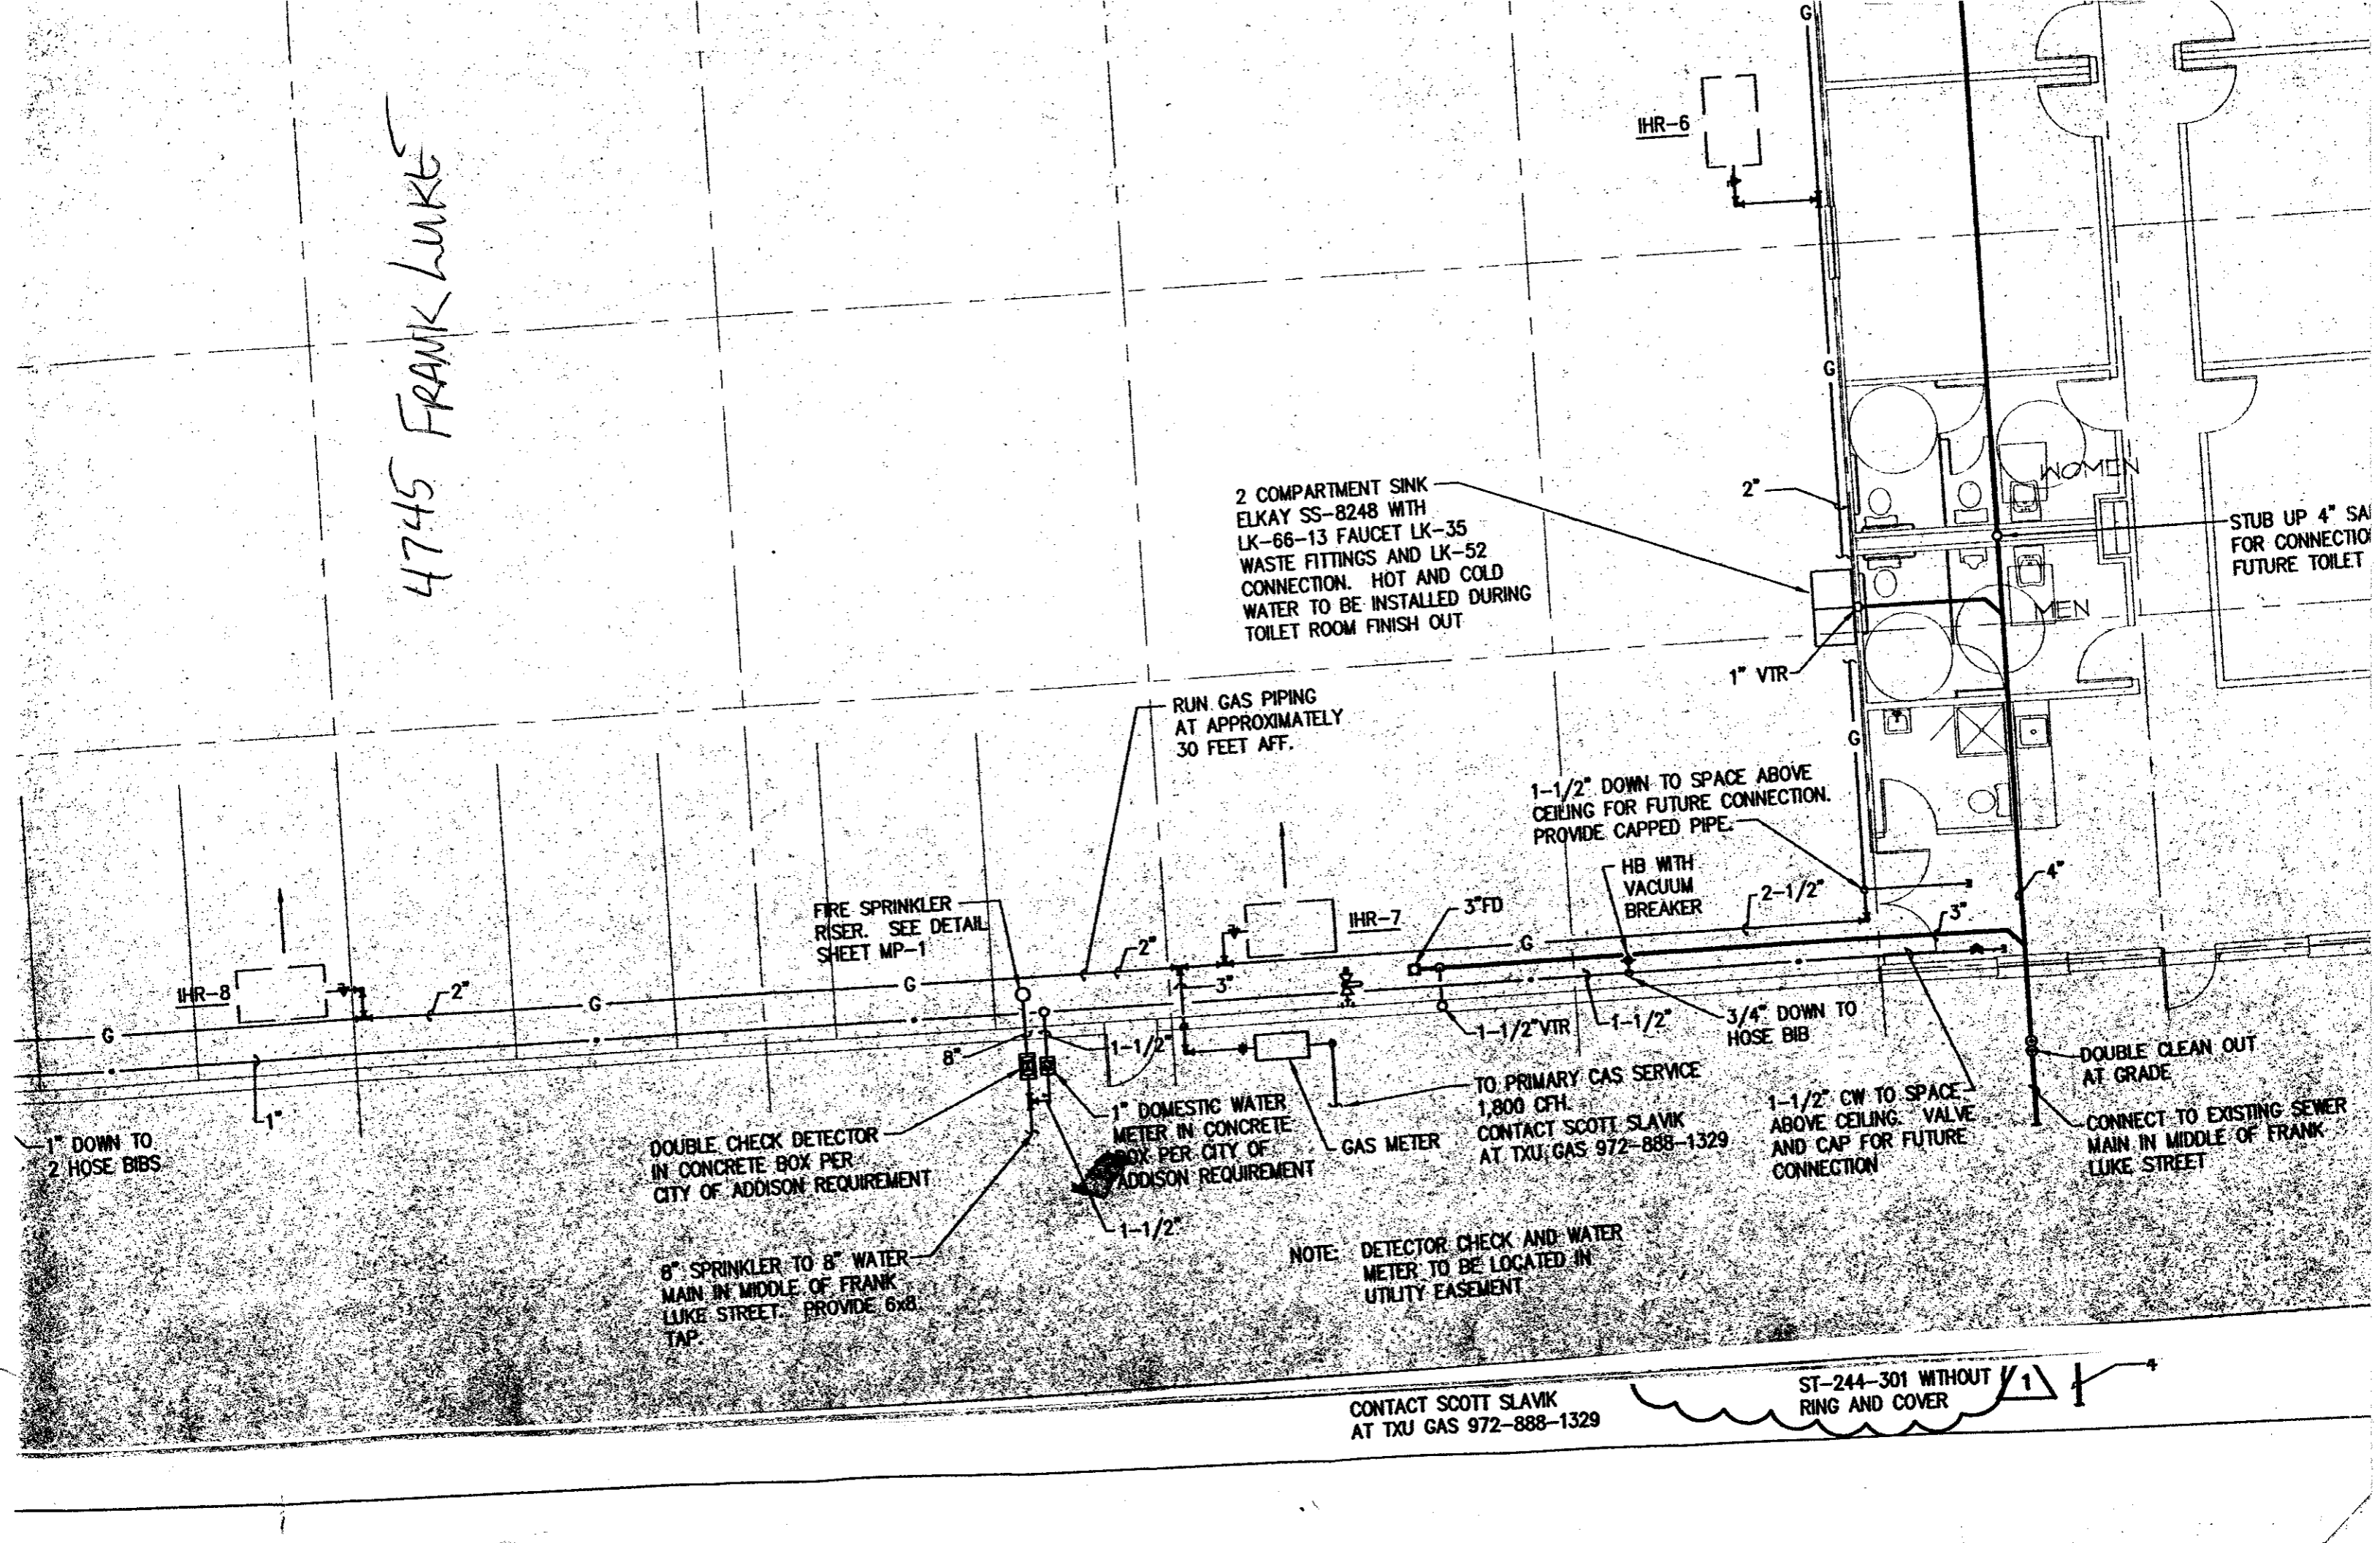

2 COMPARTMENT SINK  
ELKAY SS-8248 WITH  
LK-66-13 FAUCET LK-35  
WASTE FITTINGS AND LK-52  
CONNECTION. HOT AND COLD  
WATER TO BE INSTALLED DURING  
TOILET ROOM FINISH OUT

RUN GAS PIPING  
AT APPROXIMATELY  
30 FEET AFF.

1-1/2" DOWN TO SPACE ABOVE  
CEILING FOR FUTURE CONNECTION.  
PROVIDE CAPPED PIPE.

HB WITH  
VACUUM  
BREAKER

FIRE SPRINKLER  
RISER. SEE DETAIL  
SHEET MP-1

1" DOWN TO  
2 HOSE BIBS

DOUBLE CHECK DETECTOR  
IN CONCRETE BOX PER  
CITY OF ADDISON REQUIREMENT

1" DOMESTIC WATER  
METER IN CONCRETE  
BOX PER CITY OF  
ADDISON REQUIREMENT

GAS METER

TO PRIMARY GAS SERVICE  
1,800 CFH.  
CONTACT SCOTT SLAVIK  
AT TXU GAS 972-888-1329

1-1/2" CW TO SPACE  
ABOVE CEILING. VALVE  
AND CAP FOR FUTURE  
CONNECTION

DOUBLE CLEAN OUT  
AT GRADE

CONNECT TO EXISTING SEWER  
MAIN IN MIDDLE OF FRANK  
LUKE STREET

NOTE: DETECTOR CHECK AND WATER  
METER TO BE LOCATED IN  
UTILITY EASEMENT

CONTACT SCOTT SLAVIK  
AT TXU GAS 972-888-1329

ST-244-301 WITHOUT  
RING AND COVER