


PLANS FOR ADDISON AIRPORT FUEL FARM SPILL CONTAINMENT PADS ADDISON, TEXAS

PREPARED BY

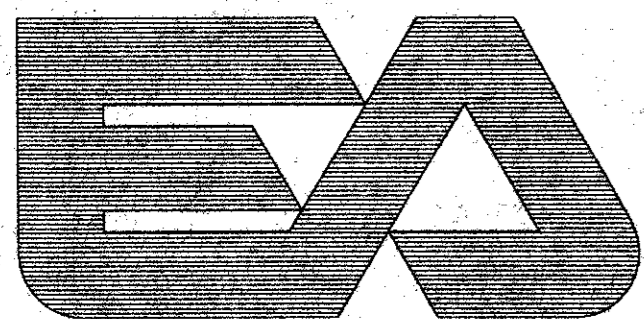


EA ENGINEERING,
SCIENCE, AND
TECHNOLOGY, INC.

1420 VALWOOD PARKWAY
SUITE 170
CARROLLTON, TEXAS 75006
(972) 484-1420

ALASKA	MARYLAND
CALIFORNIA	MASSACHUSETTS
COLORADO	NEBRASKA
DELAWARE	NEW JERSEY
FLORIDA	NEW YORK
GEORGIA	NORTH CAROLINA
HAWAII	TEXAS
ILLINOIS	WASHINGTON

NO.	DESCRIPTION
1	TITLE SHEET
2	SPILL CONTAINMENT PADS
3	DETAILS

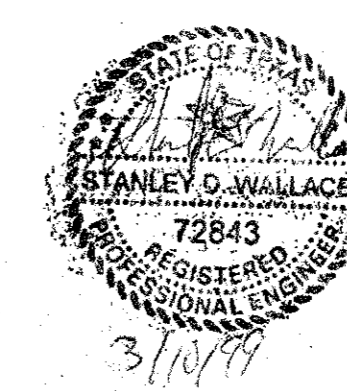

CONSTRUCTION SET
ISSUED BY
TOWN OF ADDISON
PUBLIC WORKS DEPARTMENT

DATE: 11/7/99 DATE: 11/5/99
As Built Submitted By
Riverway Contractors
Dick Hightower
5-31-00