


# PLANS FOR ADDISON AIRPORT FUEL FARM SPILL CONTAINMENT PADS ADDISON, TEXAS

PREPARED BY

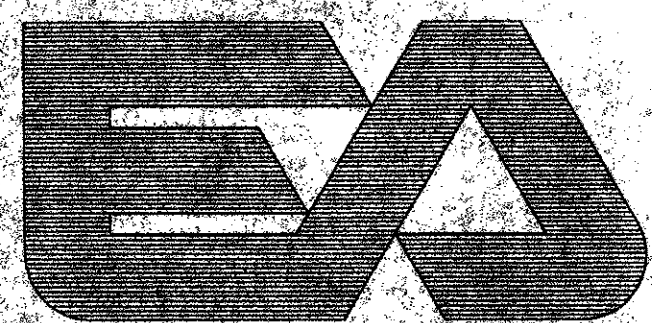


EA ENGINEERING,  
SCIENCE, AND  
TECHNOLOGY, INC.

1420 VALWOOD PARKWAY  
SUITE 170  
CARROLLTON, TEXAS 75006  
(972) 484-1420

ALASKA	MARYLAND
CALIFORNIA	MASSACHUSETTS
COLORADO	NEBRASKA
DELAWARE	NEW JERSEY
FLORIDA	NEW YORK
GEORGIA	NORTH CAROLINA
HAWAII	TEXAS
ILLINOIS	WASHINGTON

NO.	DESCRIPTION
1	TITLE SHEET
2	SPILL CONTAINMENT PADS
3	DETAILS

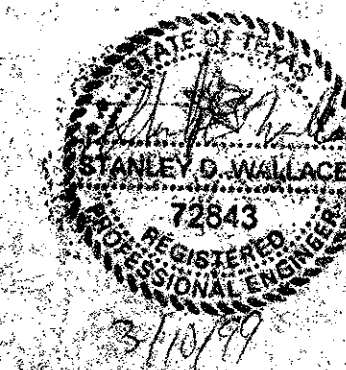

**CONSTRUCTION SET**  
ISSUED BY  
TOWN OF ADDISON  
PUBLIC WORKS DEPARTMENT

*As Built* Submitted By  
*Riverway Contractors*  
*Dick Hightower*  
5-31-00