



NOTES
 ALL ABOVE DETAILS SCALE: 1/4"=1'-0"
 ALL CONC. SLABS REINFORCED WITH #3 @ 12" O.C. BOTHWAYS

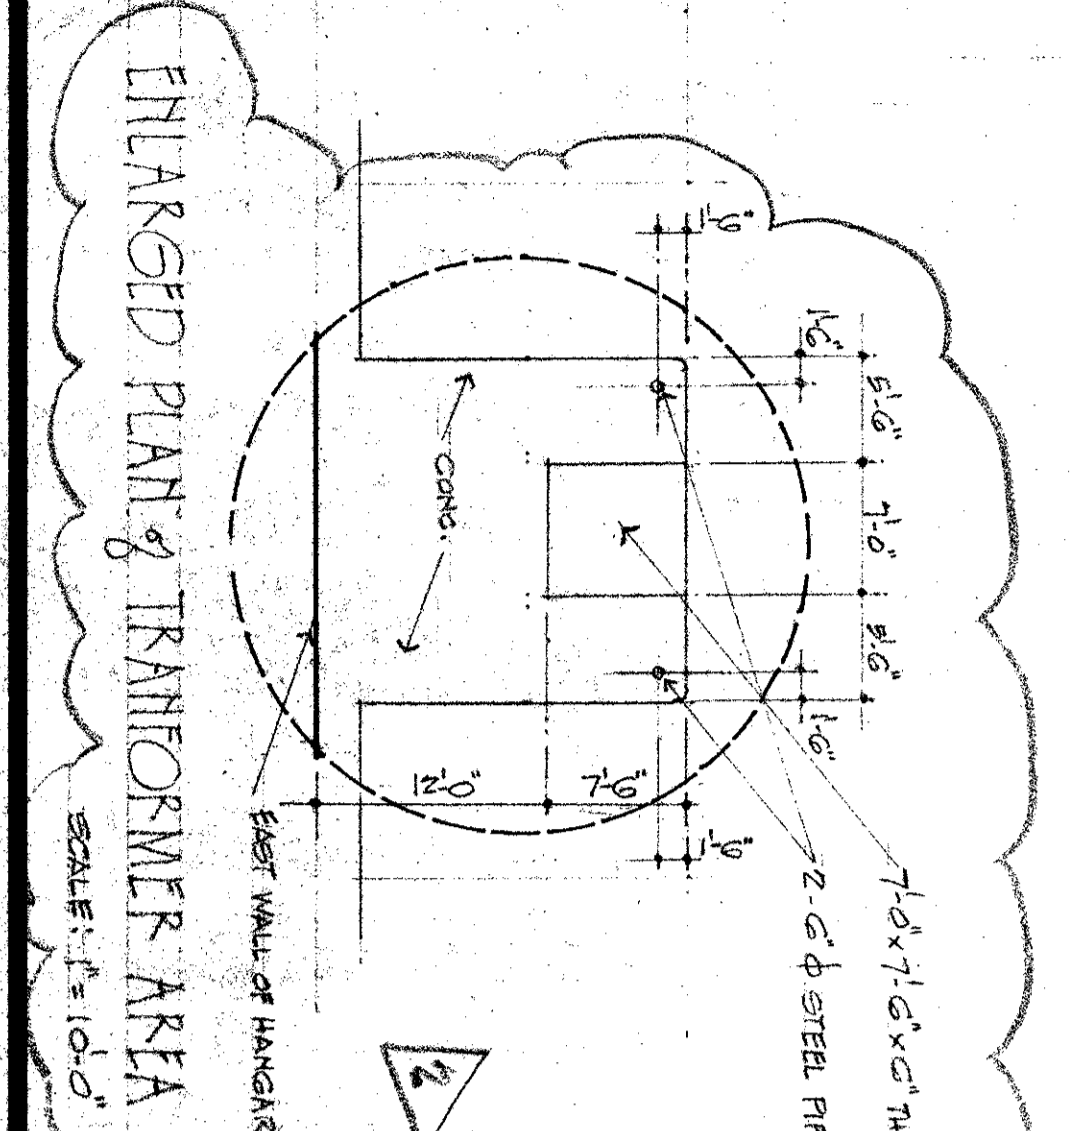

DOOR SCHEDULE	REMARKS
1	3'-0" x 7'-0" x 1 1/2"
2	3'-0" x 7'-0" x 1 1/2"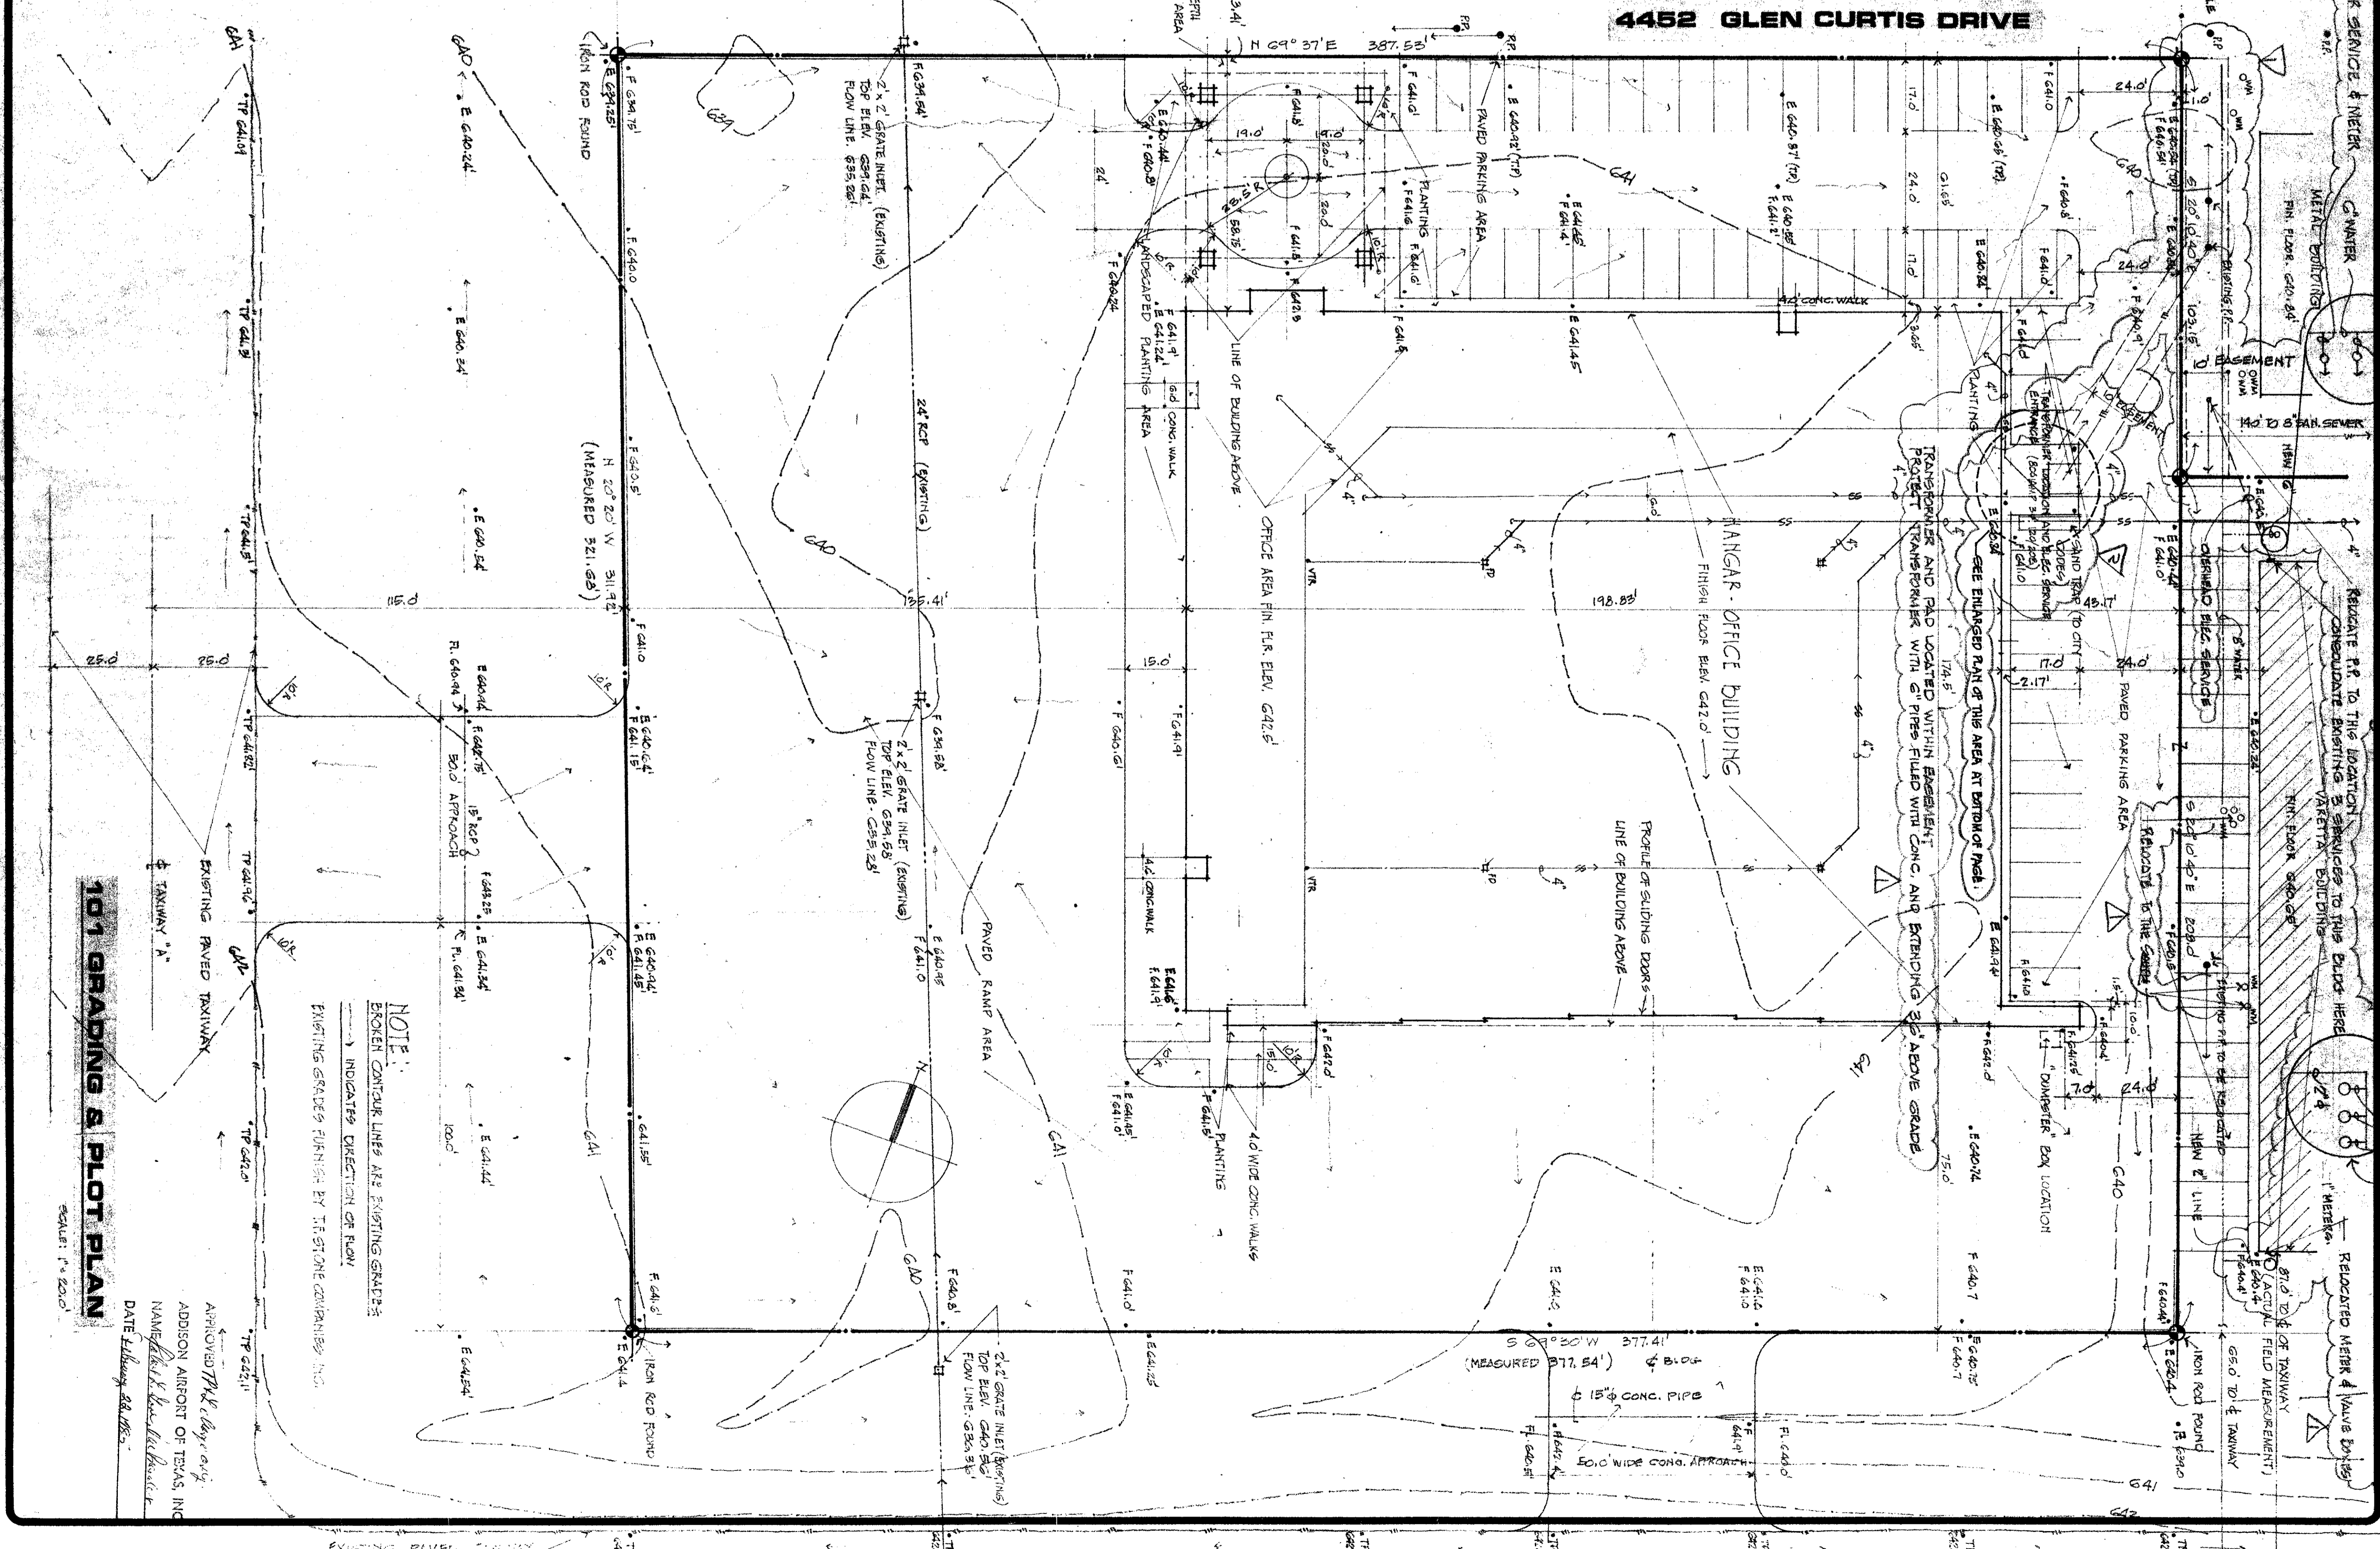
DATE	SCALE	SHEET
8/20/21	AS SHOWN	1

PLOT PLAN & DETAILS
FOR HANGAR-OFFICE BUILDING
ADDISON AIRPORT, ADDISON, TEXAS

STONE
 T.F. Stone Companies, Inc.
 Liberty Plaza I
 6005 Kellen Springs Blvd. Suite 500
 Dallas, Texas 75246

REGISTERED ARCHITECT
STATE OF TEXAS
 REG. NO. 6418

ROGER SMITH AIA
ARCHITECT
 8306 WILEY POST DR.
 CARROLLTON, TEXAS, 75006
 987-4701

PROFESSIONAL SEAL
 REGISTERED ARCHITECT
 STATE OF TEXAS
 AREA 2-21-85