


# Addison!

## CONSTRUCTION PLANS FOR ~~PROPERTY~~ ADDISON AIRPORT RECLAMATION LAND

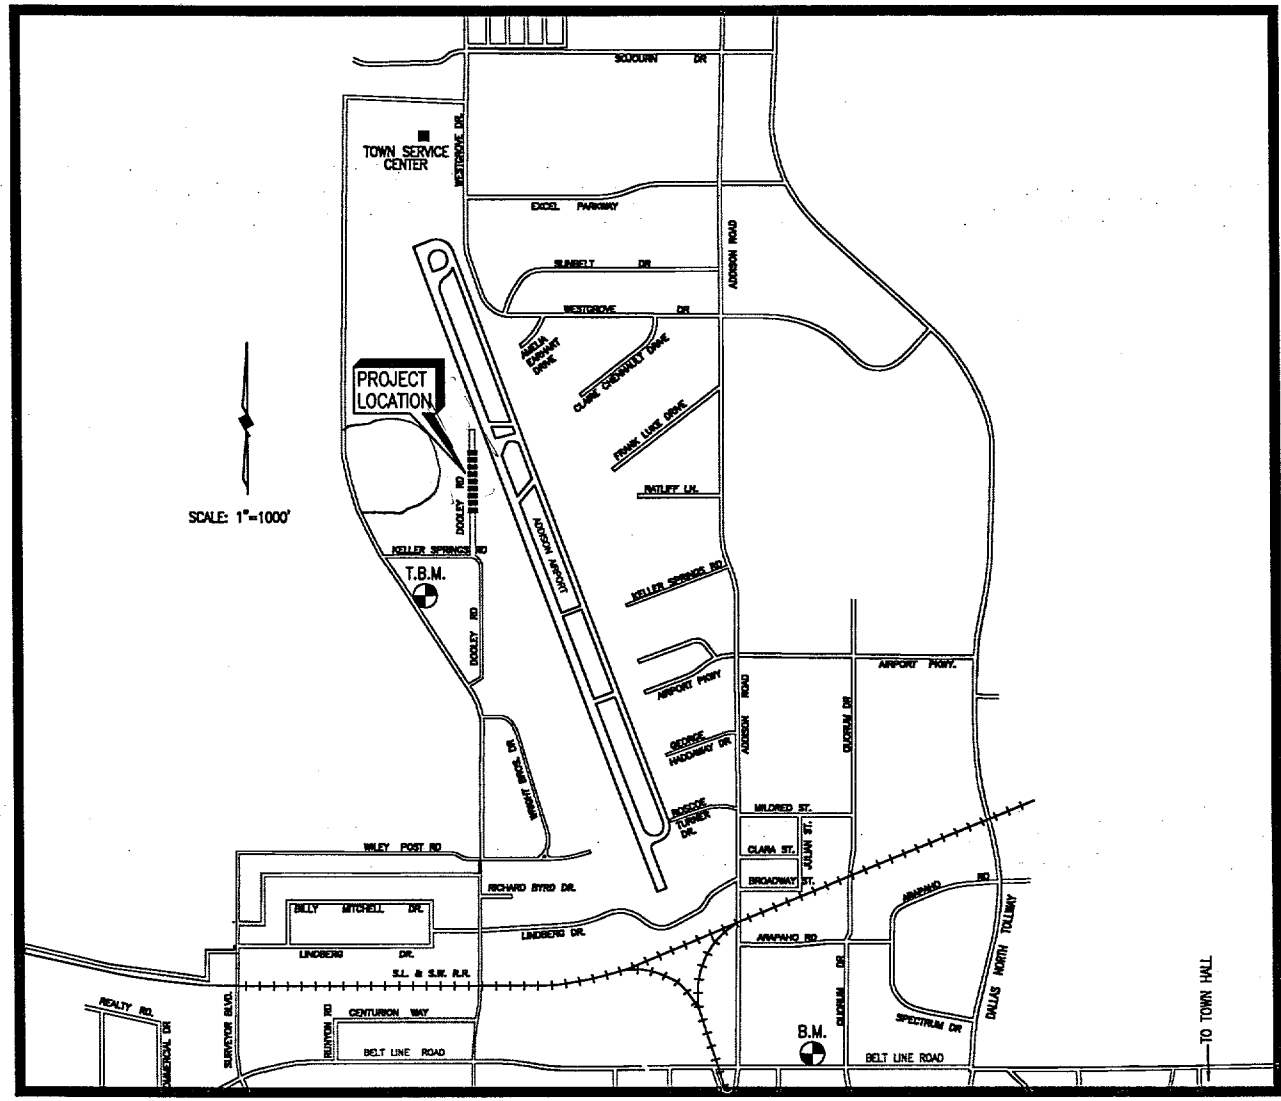

*AS-Built Essentially as planned, except additional fill was placed on former Chester Property.*

SHIMEK, JACOBS & FINKLEA, L.L.P.  
 CONSULTING ENGINEERS  
 Dallas, Texas

NOT TO SCALE

FEBRUARY 1998

### SHEET INDEX

SHEET DESCRIPTION	SHEET NO.
CONSTRUCTION PLAN	1
EXISTING GRADING PLAN	2
PROPOSED GRADING PLAN	3
CROSS SECTIONS	4 & 5
DETAILS	6 & 7

BID SET



THESE DOCUMENTS ARE FOR BIDDING, CONSTRUCTION, AND PERMIT PURPOSES.  
*John W. Brinkhoff*  
 DATE: 3/17/98

FF-16

REVISED 03/16/98 B.L. 98100-00.DWG SCALE: 1=1 BLOCKS: LOC-INT IMAGE: ADDISON.TIF