




**A TUNNEL SECTION**  
M138 SCALE: 1/4" = 1'-0"

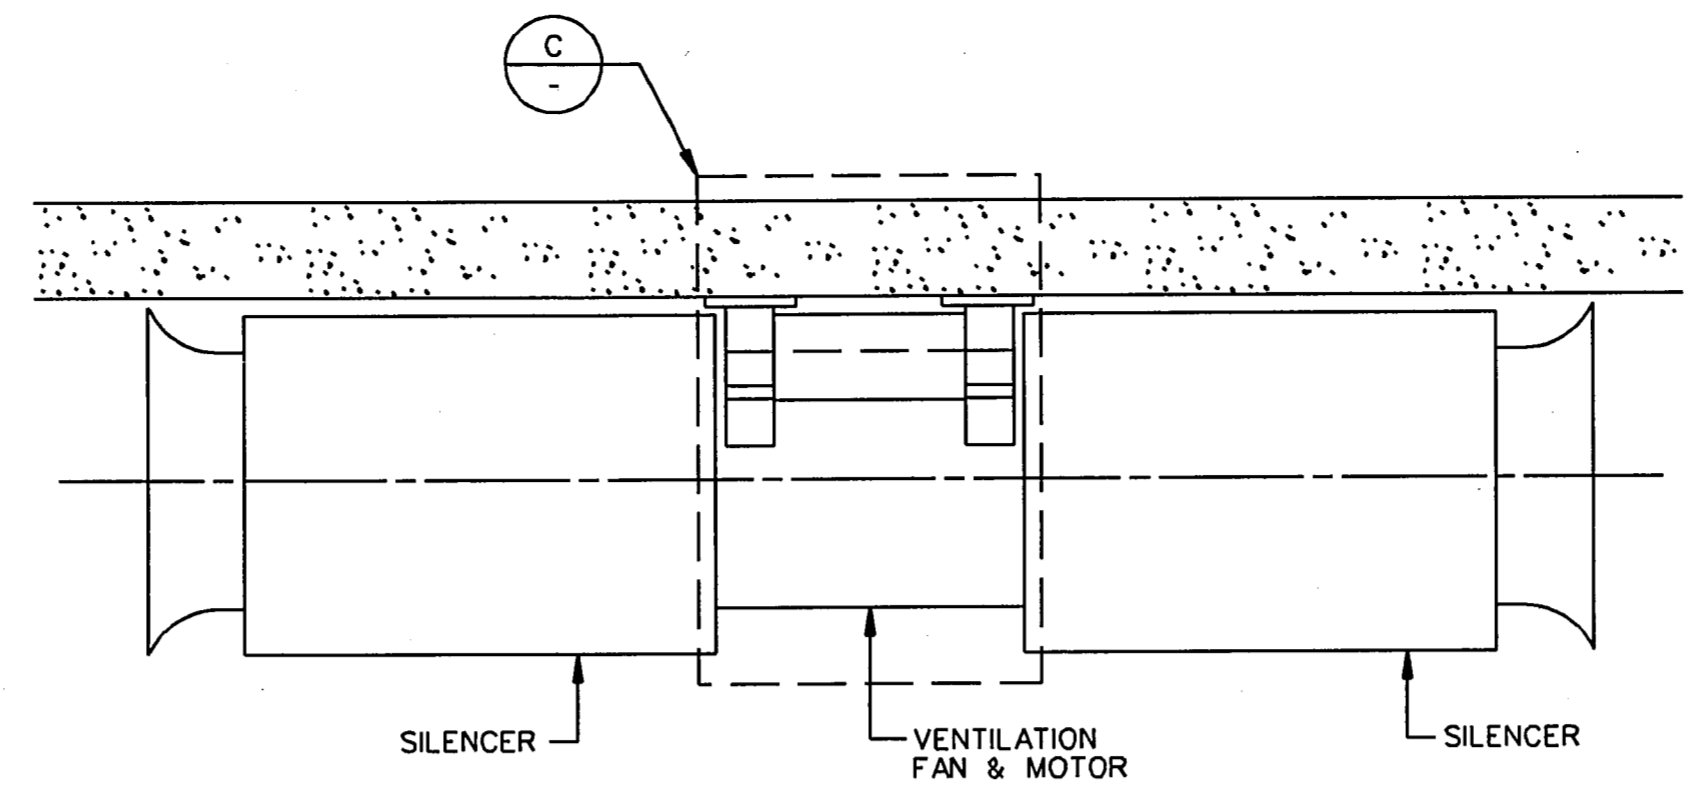

**B FAN ELEVATION**  
SCALE: 1/2" = 1'-0"

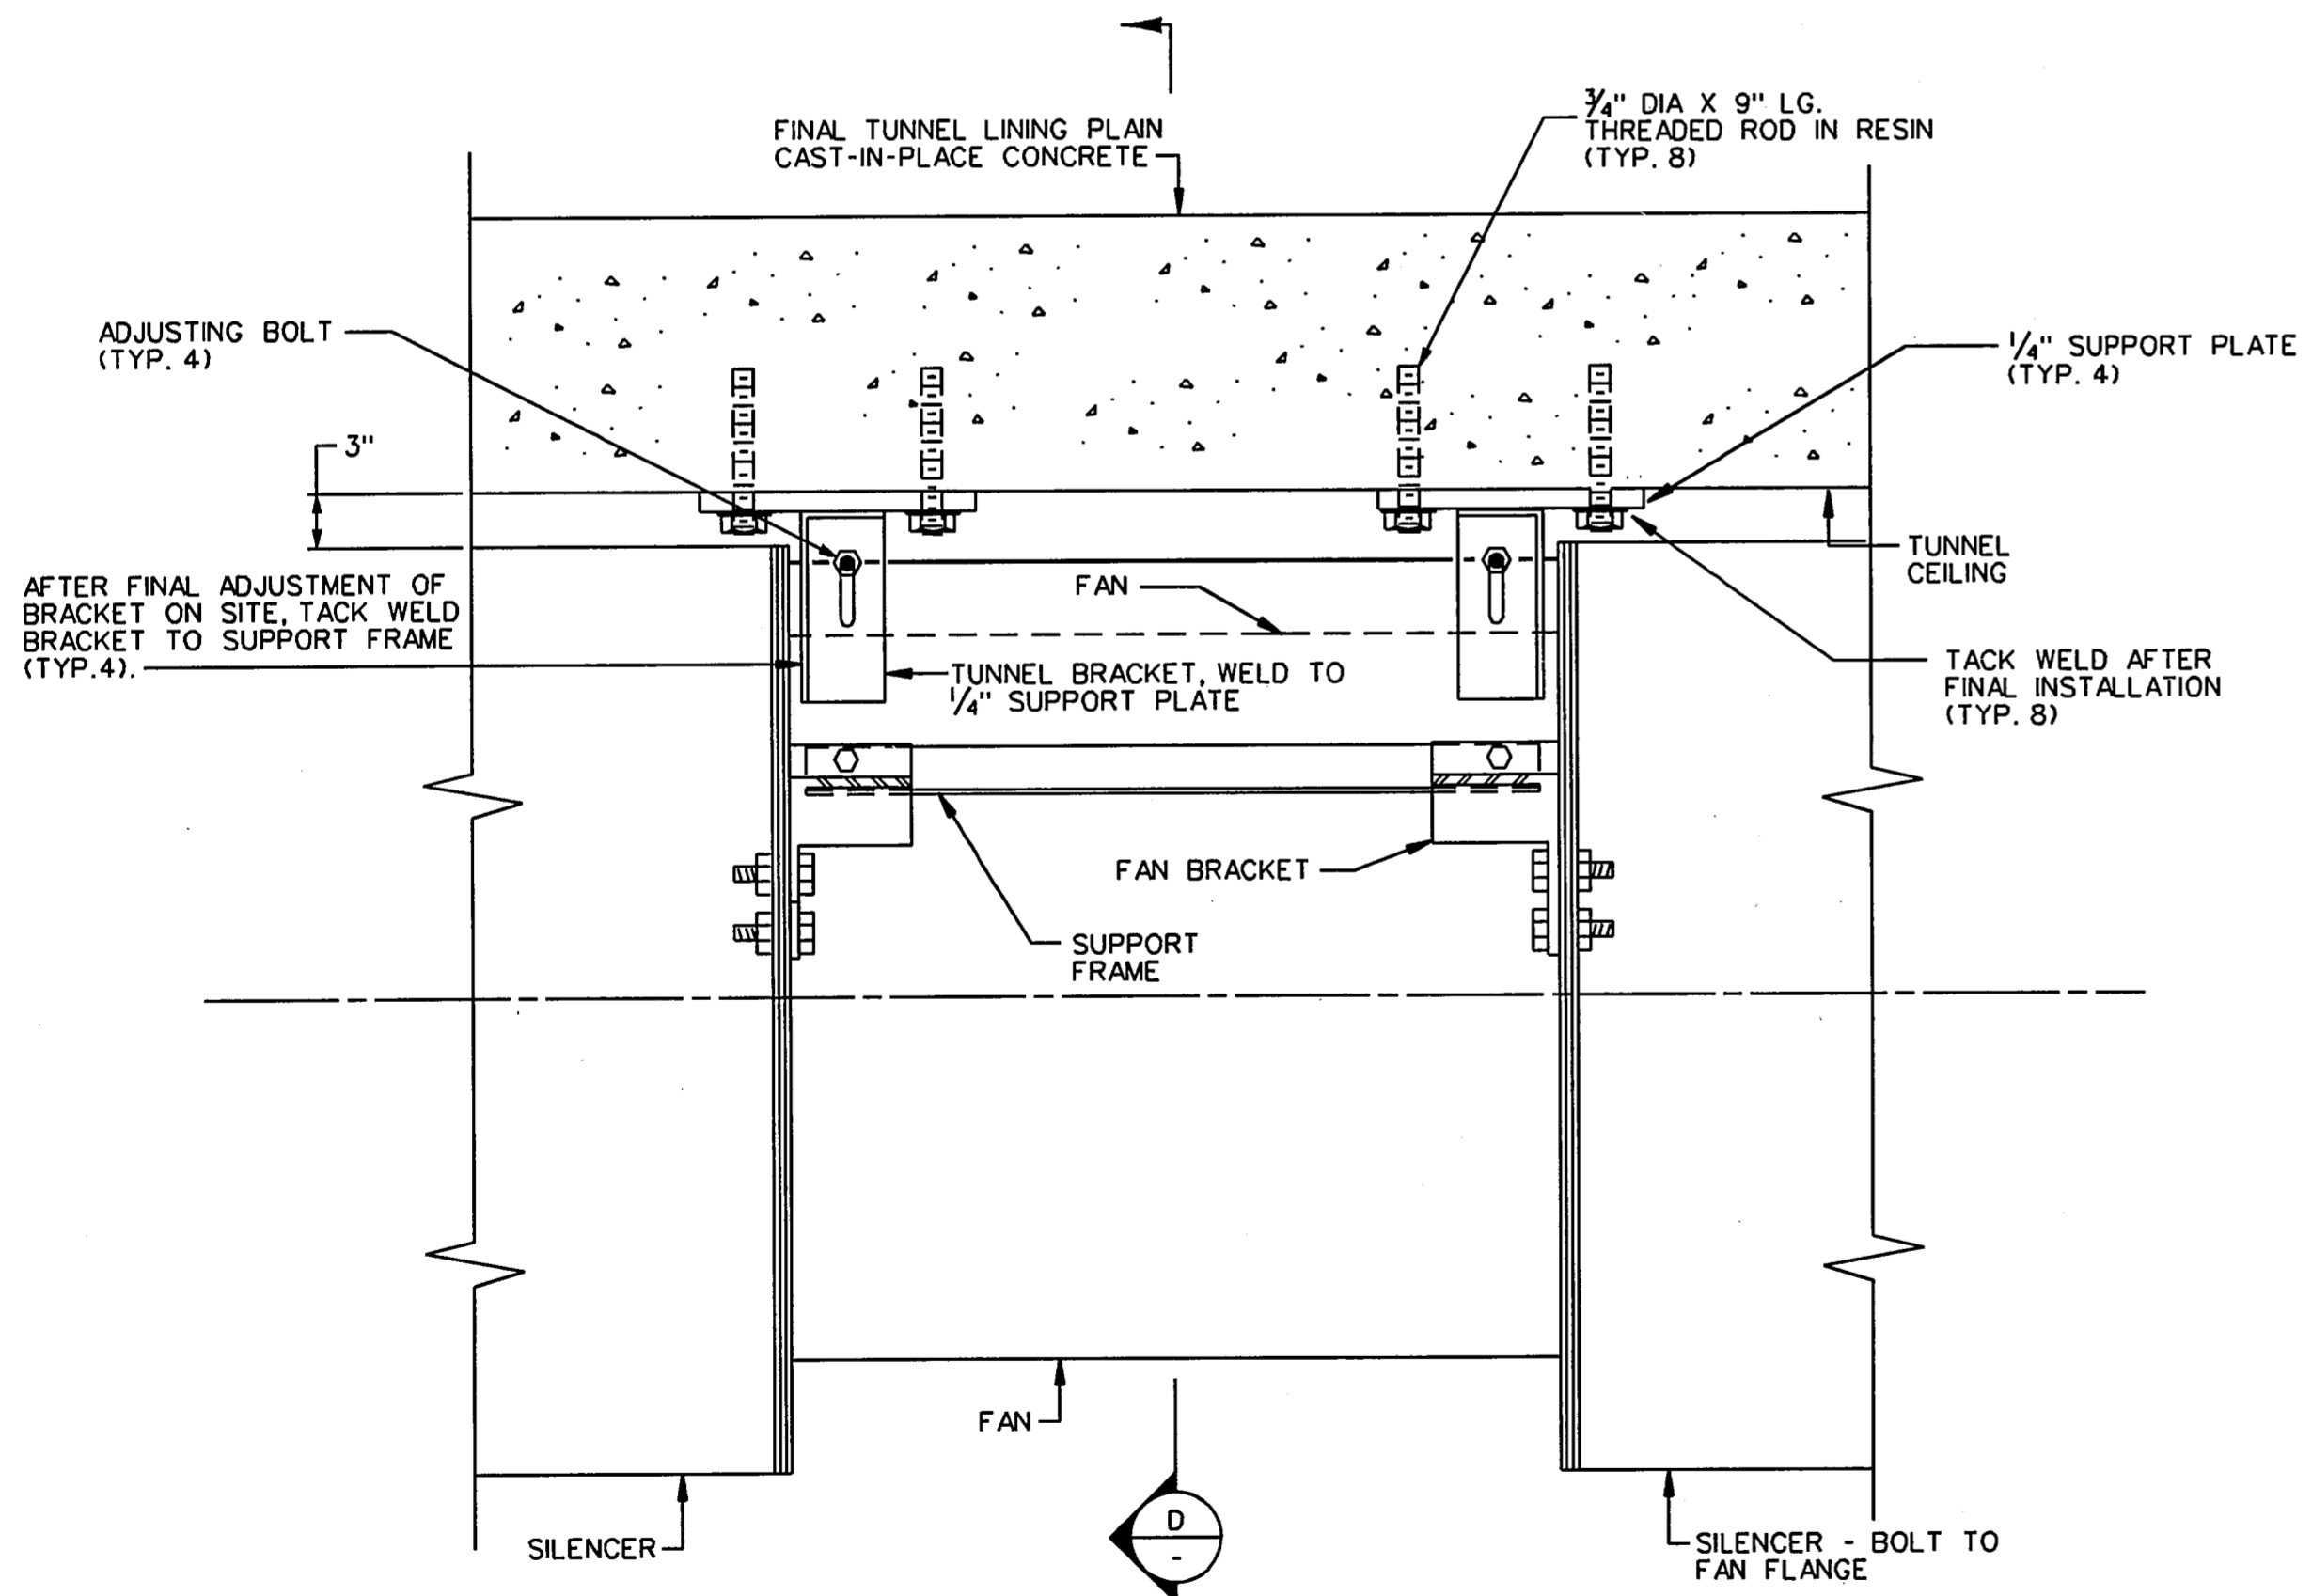

**C FAN MOUNTING DETAIL**  
NO SCALE

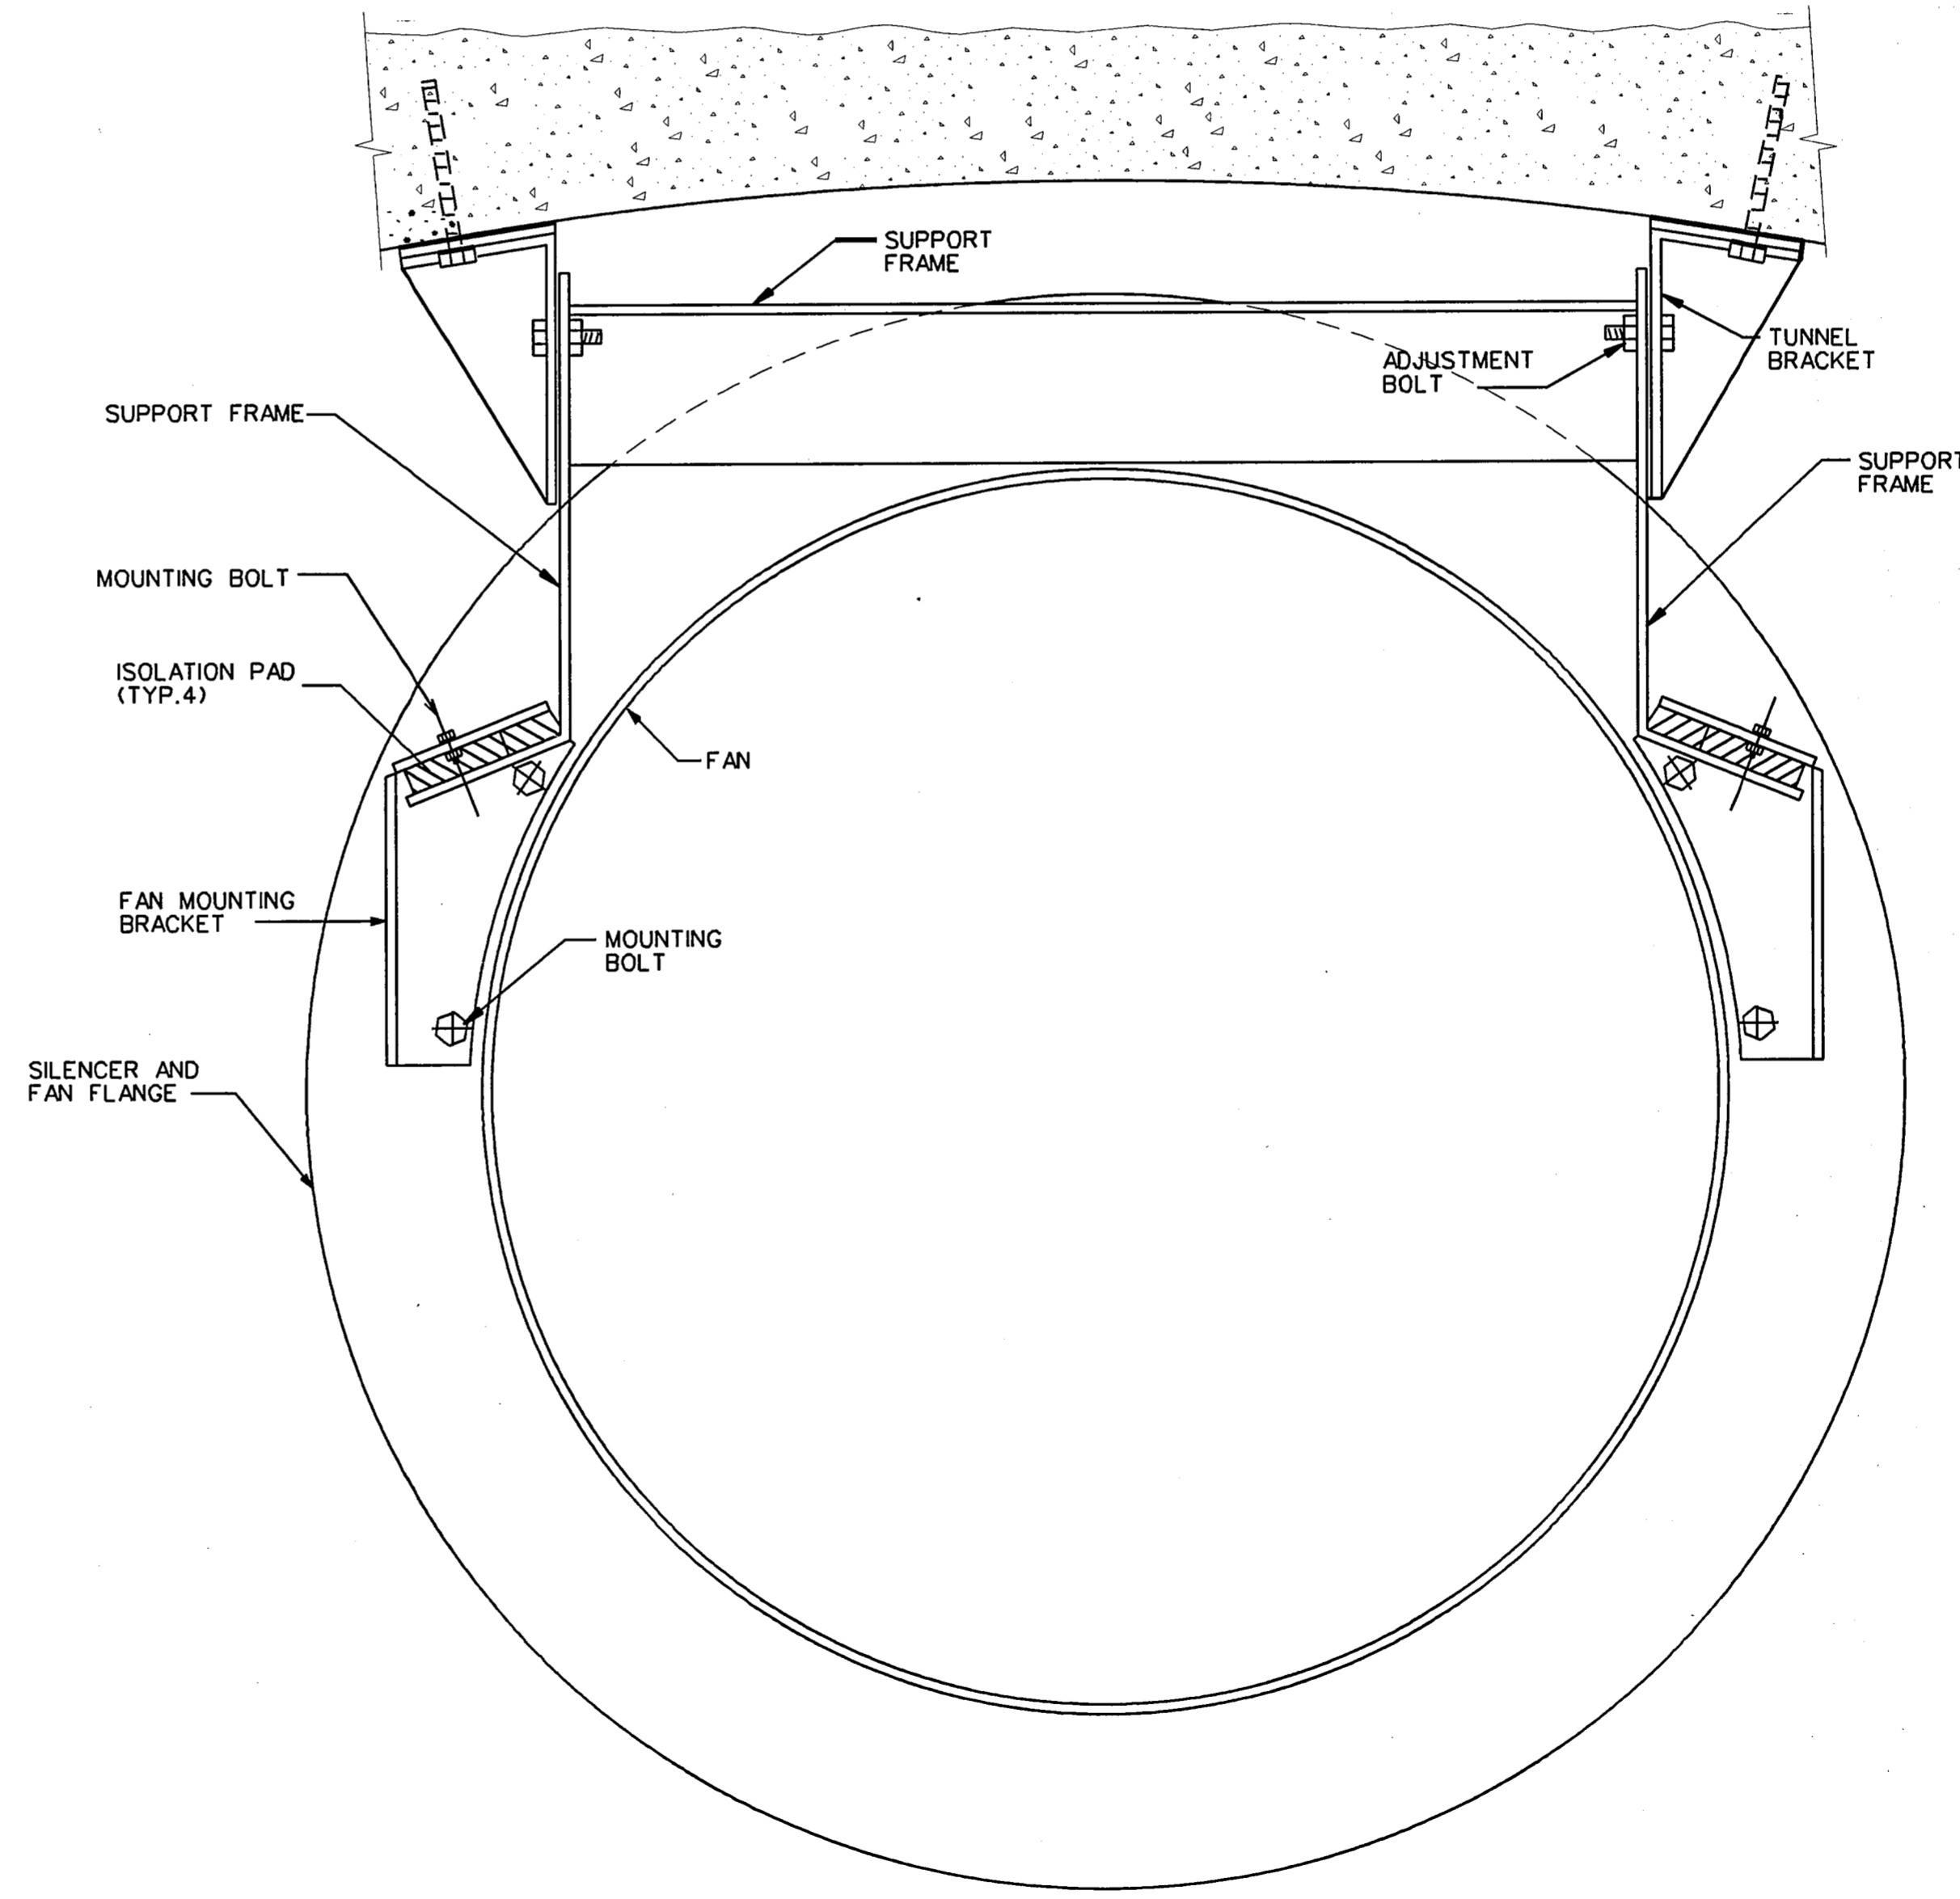

**D FAN MOUNTING BRACKET DETAIL**  
NO SCALE

**GENERAL NOTES:**

- A. SUPPORT FANS AND SILENCERS IN ACCORDANCE WITH THE REQUIREMENTS OF THIS DRAWING AND THE MANUFACTURER'S RECOMMENDATIONS.
- B. FAN SUPPORTS SHALL BE PROVIDED BY FAN MANUFACTURER.

C. RFI # 161  
VENT FANS - TUNNEL  
VENTILATION SYSTEM



THE SEAL APPEARING ON THIS DOCUMENT WAS AUTHORIZED BY MIKE L. ASHCRAFT, P.E., 56590 ON SEPTEMBER 9, 1996

**FINAL RECORD DRAWING**  
Date: 12/25/99

No.	REVISION	BY	DATE
TEXAS TURNPIKE AUTHORITY ADDISON AIRPORT TUNNEL			
TUNNEL VENTILATION SECTIONS			
HDR Engineering, Inc.			SECTION XIII
DRAWN: WTD	DATE: 12/05/96	DESIGNED: MLA	DATE: 08/28/96
CHECKED: BL	DATE: 08/28/96	SCALE: AS SHOWN	
CONTRACT No. DNT-260 SHEET M140 OF 166			