



SECTION AT EAST SUMP PIT (WEST SIMILAR)
P148 SCALE: 3/8" - 1'-0"

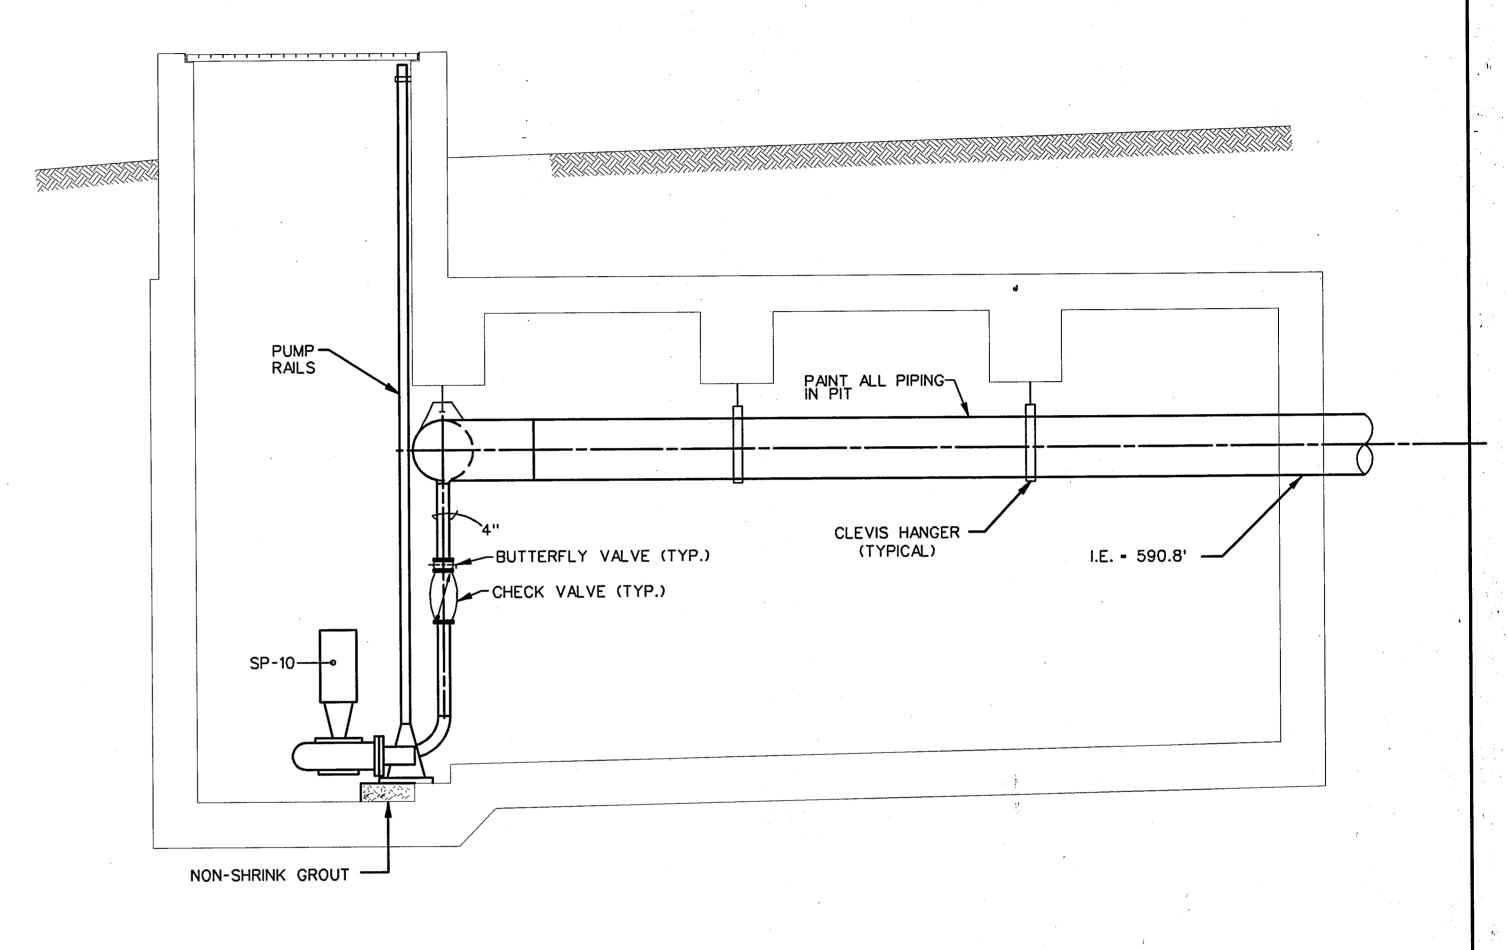

SECTION AT EAST SUMP PIT (WEST SIMILAR)

SCALE: 3/8" - 1'-0"

FINAL RECORD DRAWING Date: 12/25/99

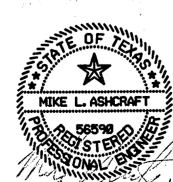

THE SEAL APPEARING ON THIS DOCUMENT WAS AUTHORIZED BY MIKE L. ASHCRAFT, P.E., 56590 ON SEPTEMBER 9, 1996

I REVISION PER RFI # 923 BY DATE REVISION TEXAS TURNPIKE AUTHORITY ADDISON AIRPORT TUNNEL **ENLARGED** SUMP PIT **PLANS** SECTION XIII DRAWN: WTD DATE: 12/05/96 DESIGNED: MLA DATE: 08/28/96 CHECKED: KG DATE: 08/28/96 SCALE: AS SHOWN CONTRACT No. <u>DNT-260</u> SHEET <u>P148</u> OF 166