

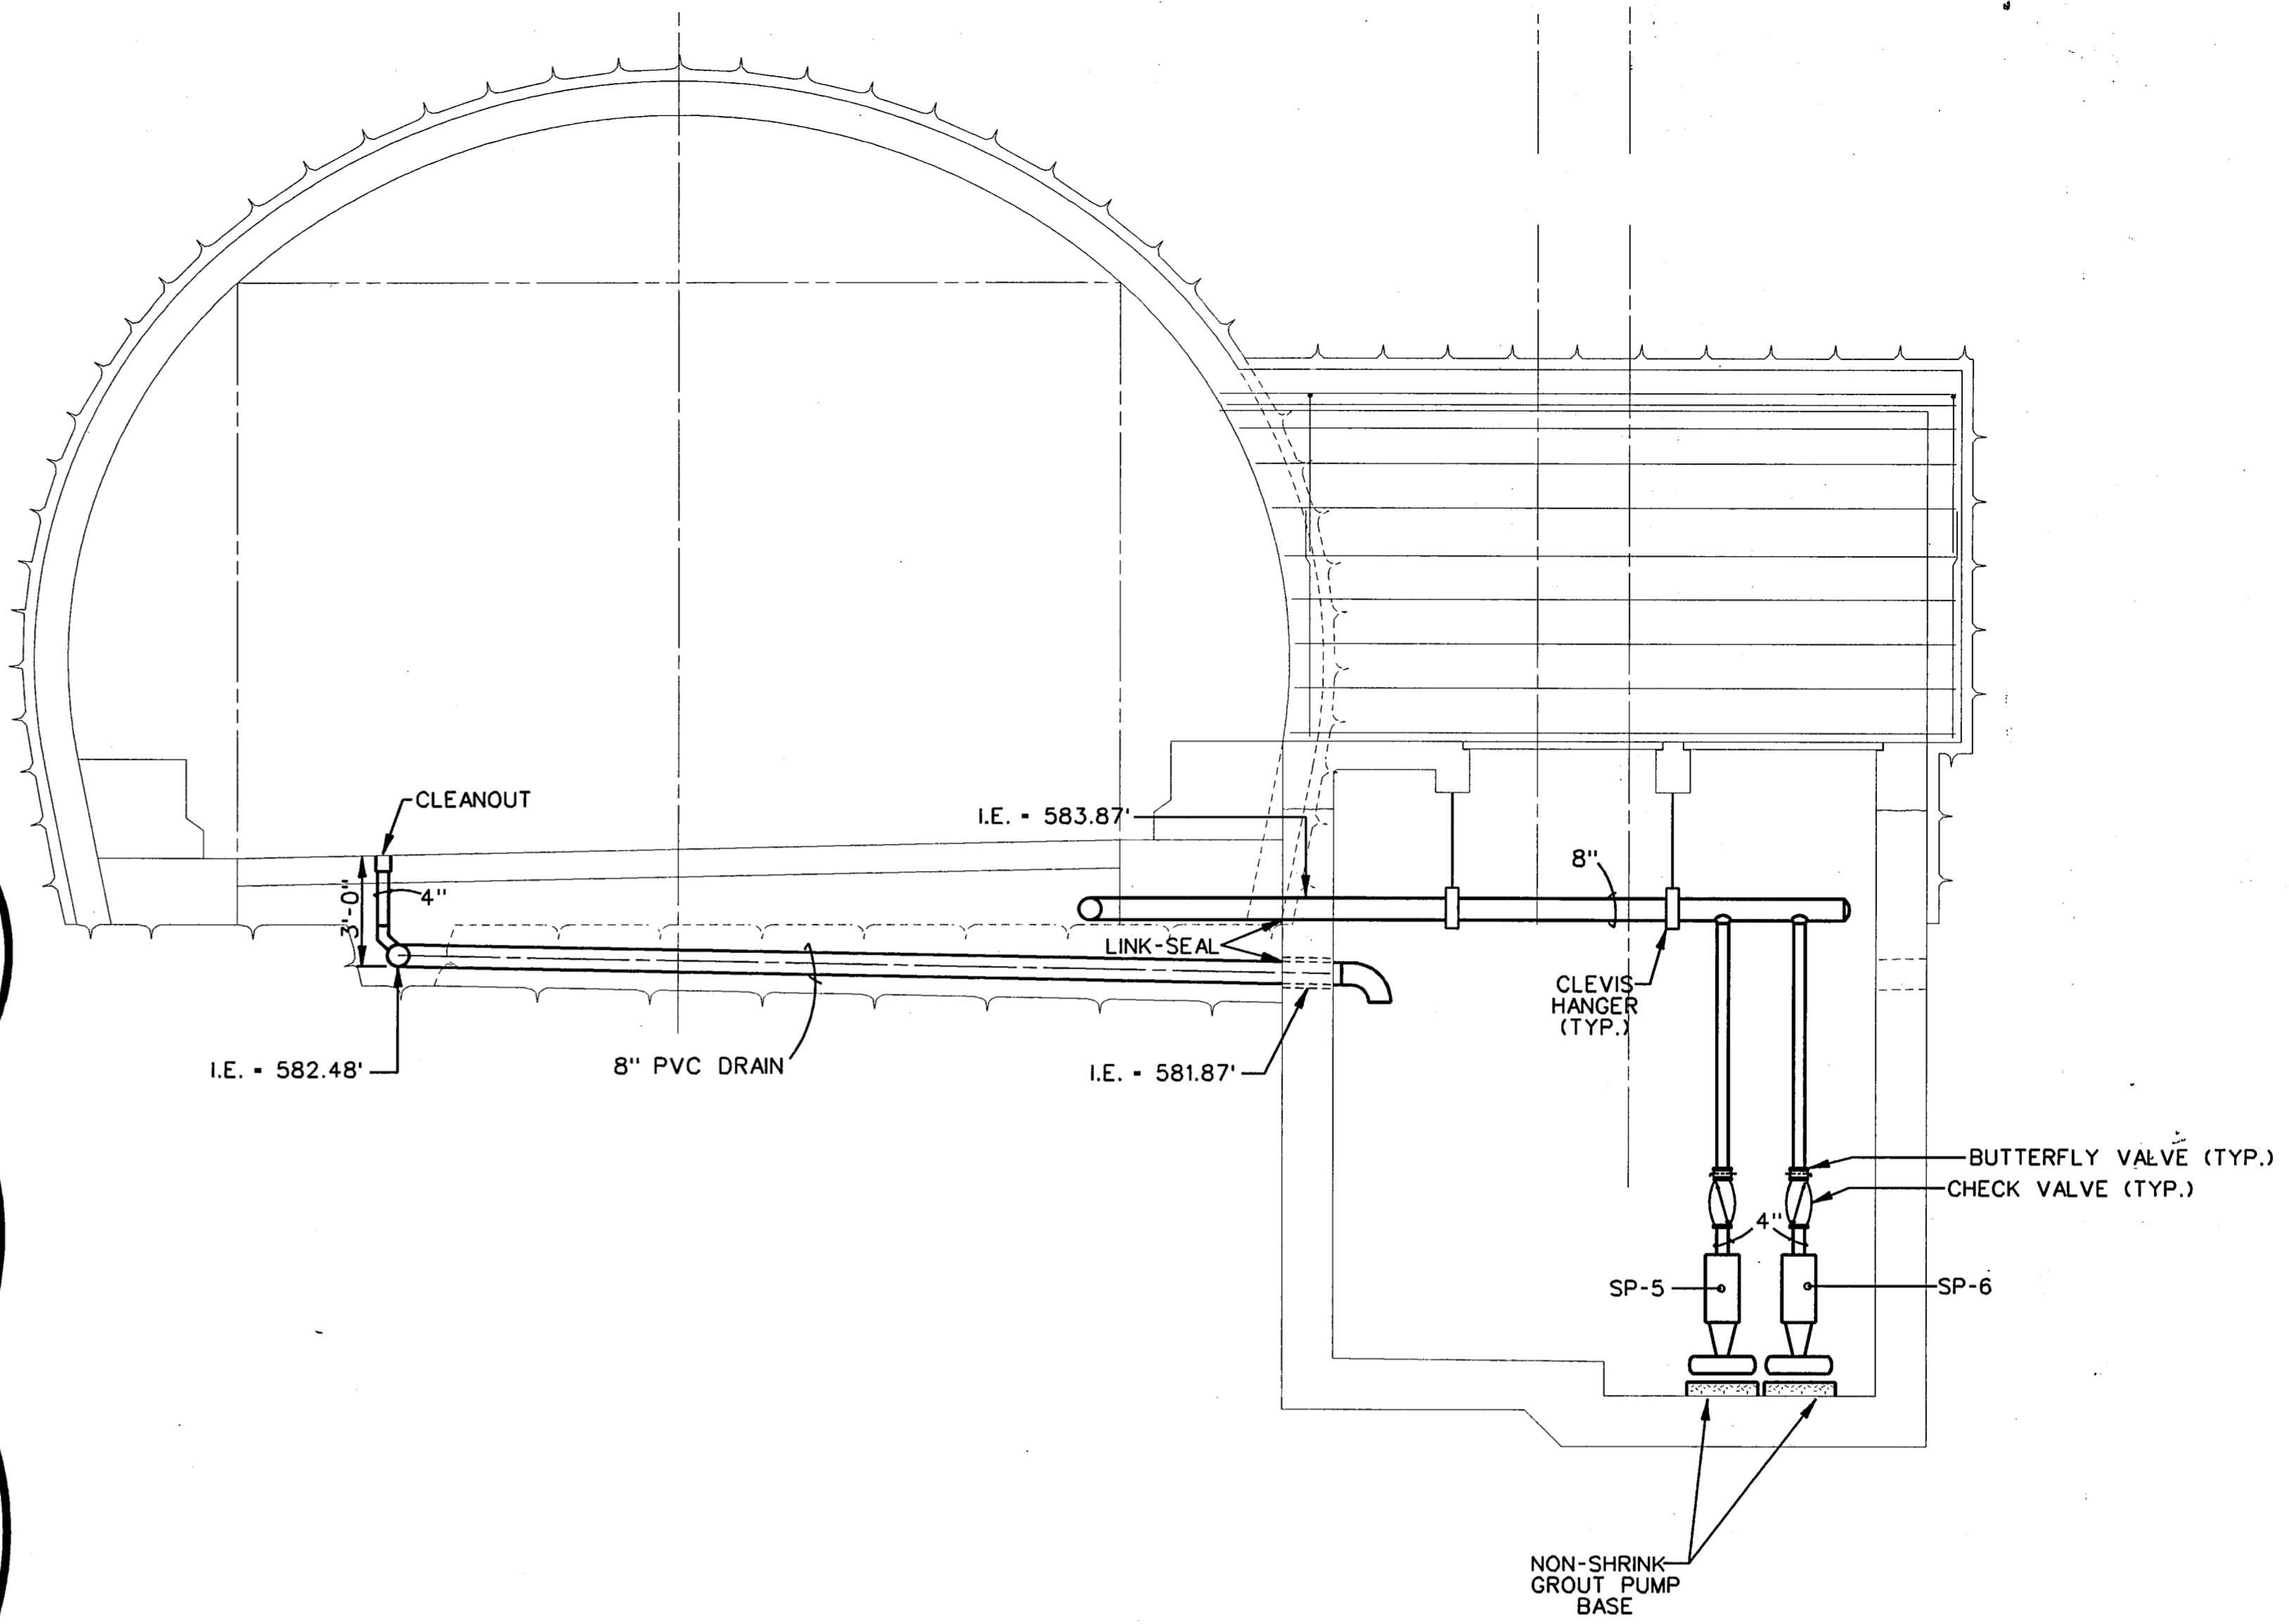


FILE: p:\addtun\adgn\adftup108.dgn  
 DATE: 23-Apr-96 20:01

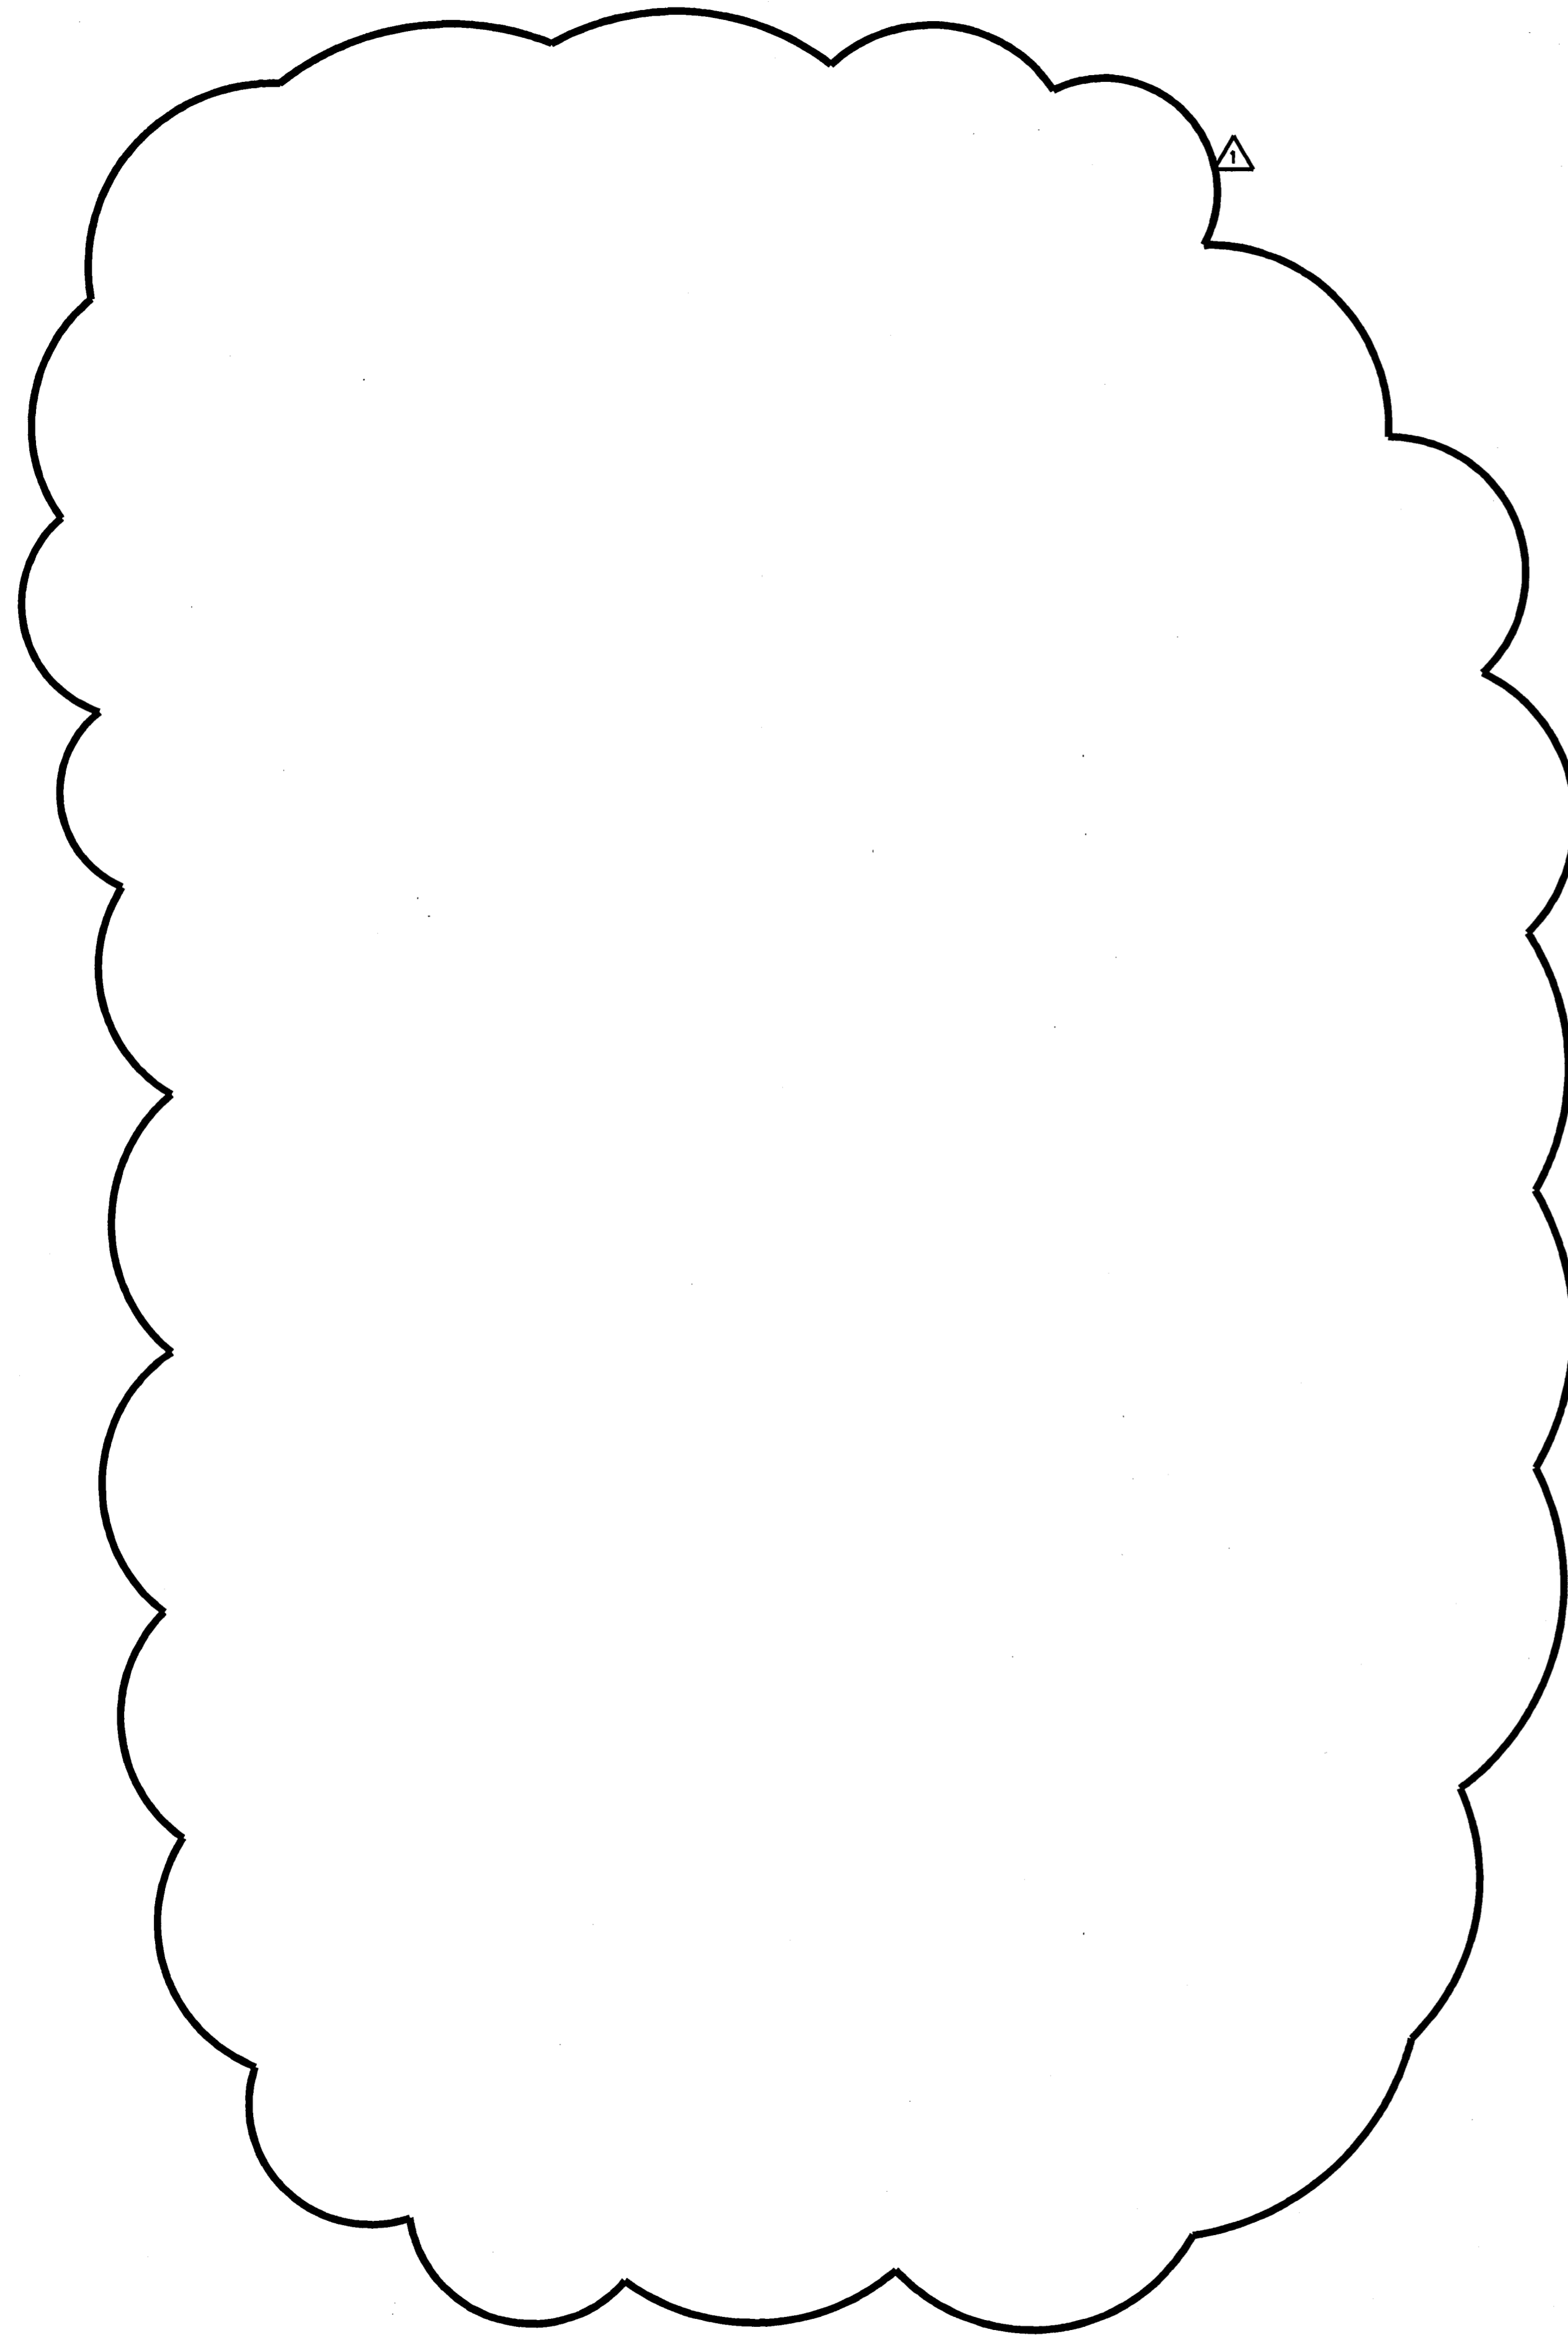

**B** SECTION AT TUNNEL SUMP PIT  
 P147 1/4" = 1'-0"

**FINAL RECORD  
 DRAWING**  
 Date: 12/25/99

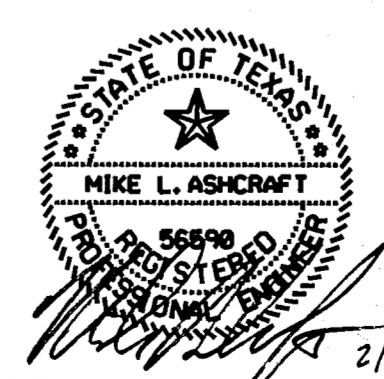

THE SEAL APPEARING ON THIS DOCUMENT WAS AUTHORIZED BY MIKE L. ASHCRAFT, P.E., 56590 ON SEPTEMBER 9, 1996

GEN. SETS		MLA	2/7/97
No.	REVISION	BY	DATE
TEXAS TURNPIKE AUTHORITY ADDISON AIRPORT TUNNEL			
TUNNEL GENERATOR & FIRE PROTECTION			
<b>HDR</b> HDR Engineering, Inc.		SECTION XIII	
DRAWN: WTD	DATE: 12/05/96	DESIGNED: MLA	DATE: 08/28/96
CHECKED: BL	DATE: 08/28/96	SCALE:	NONE
CONTRACT No. DNT-260 SHEET P151 OF 166			