



2 AT STA. 1+75

- LEGEND
- BLACK
 - BLACK
 - BLACK
 - WHITE
 - HIGH SPECIFIC INTENSITY (TY C)
 - * • SPACING REDUCED 50%

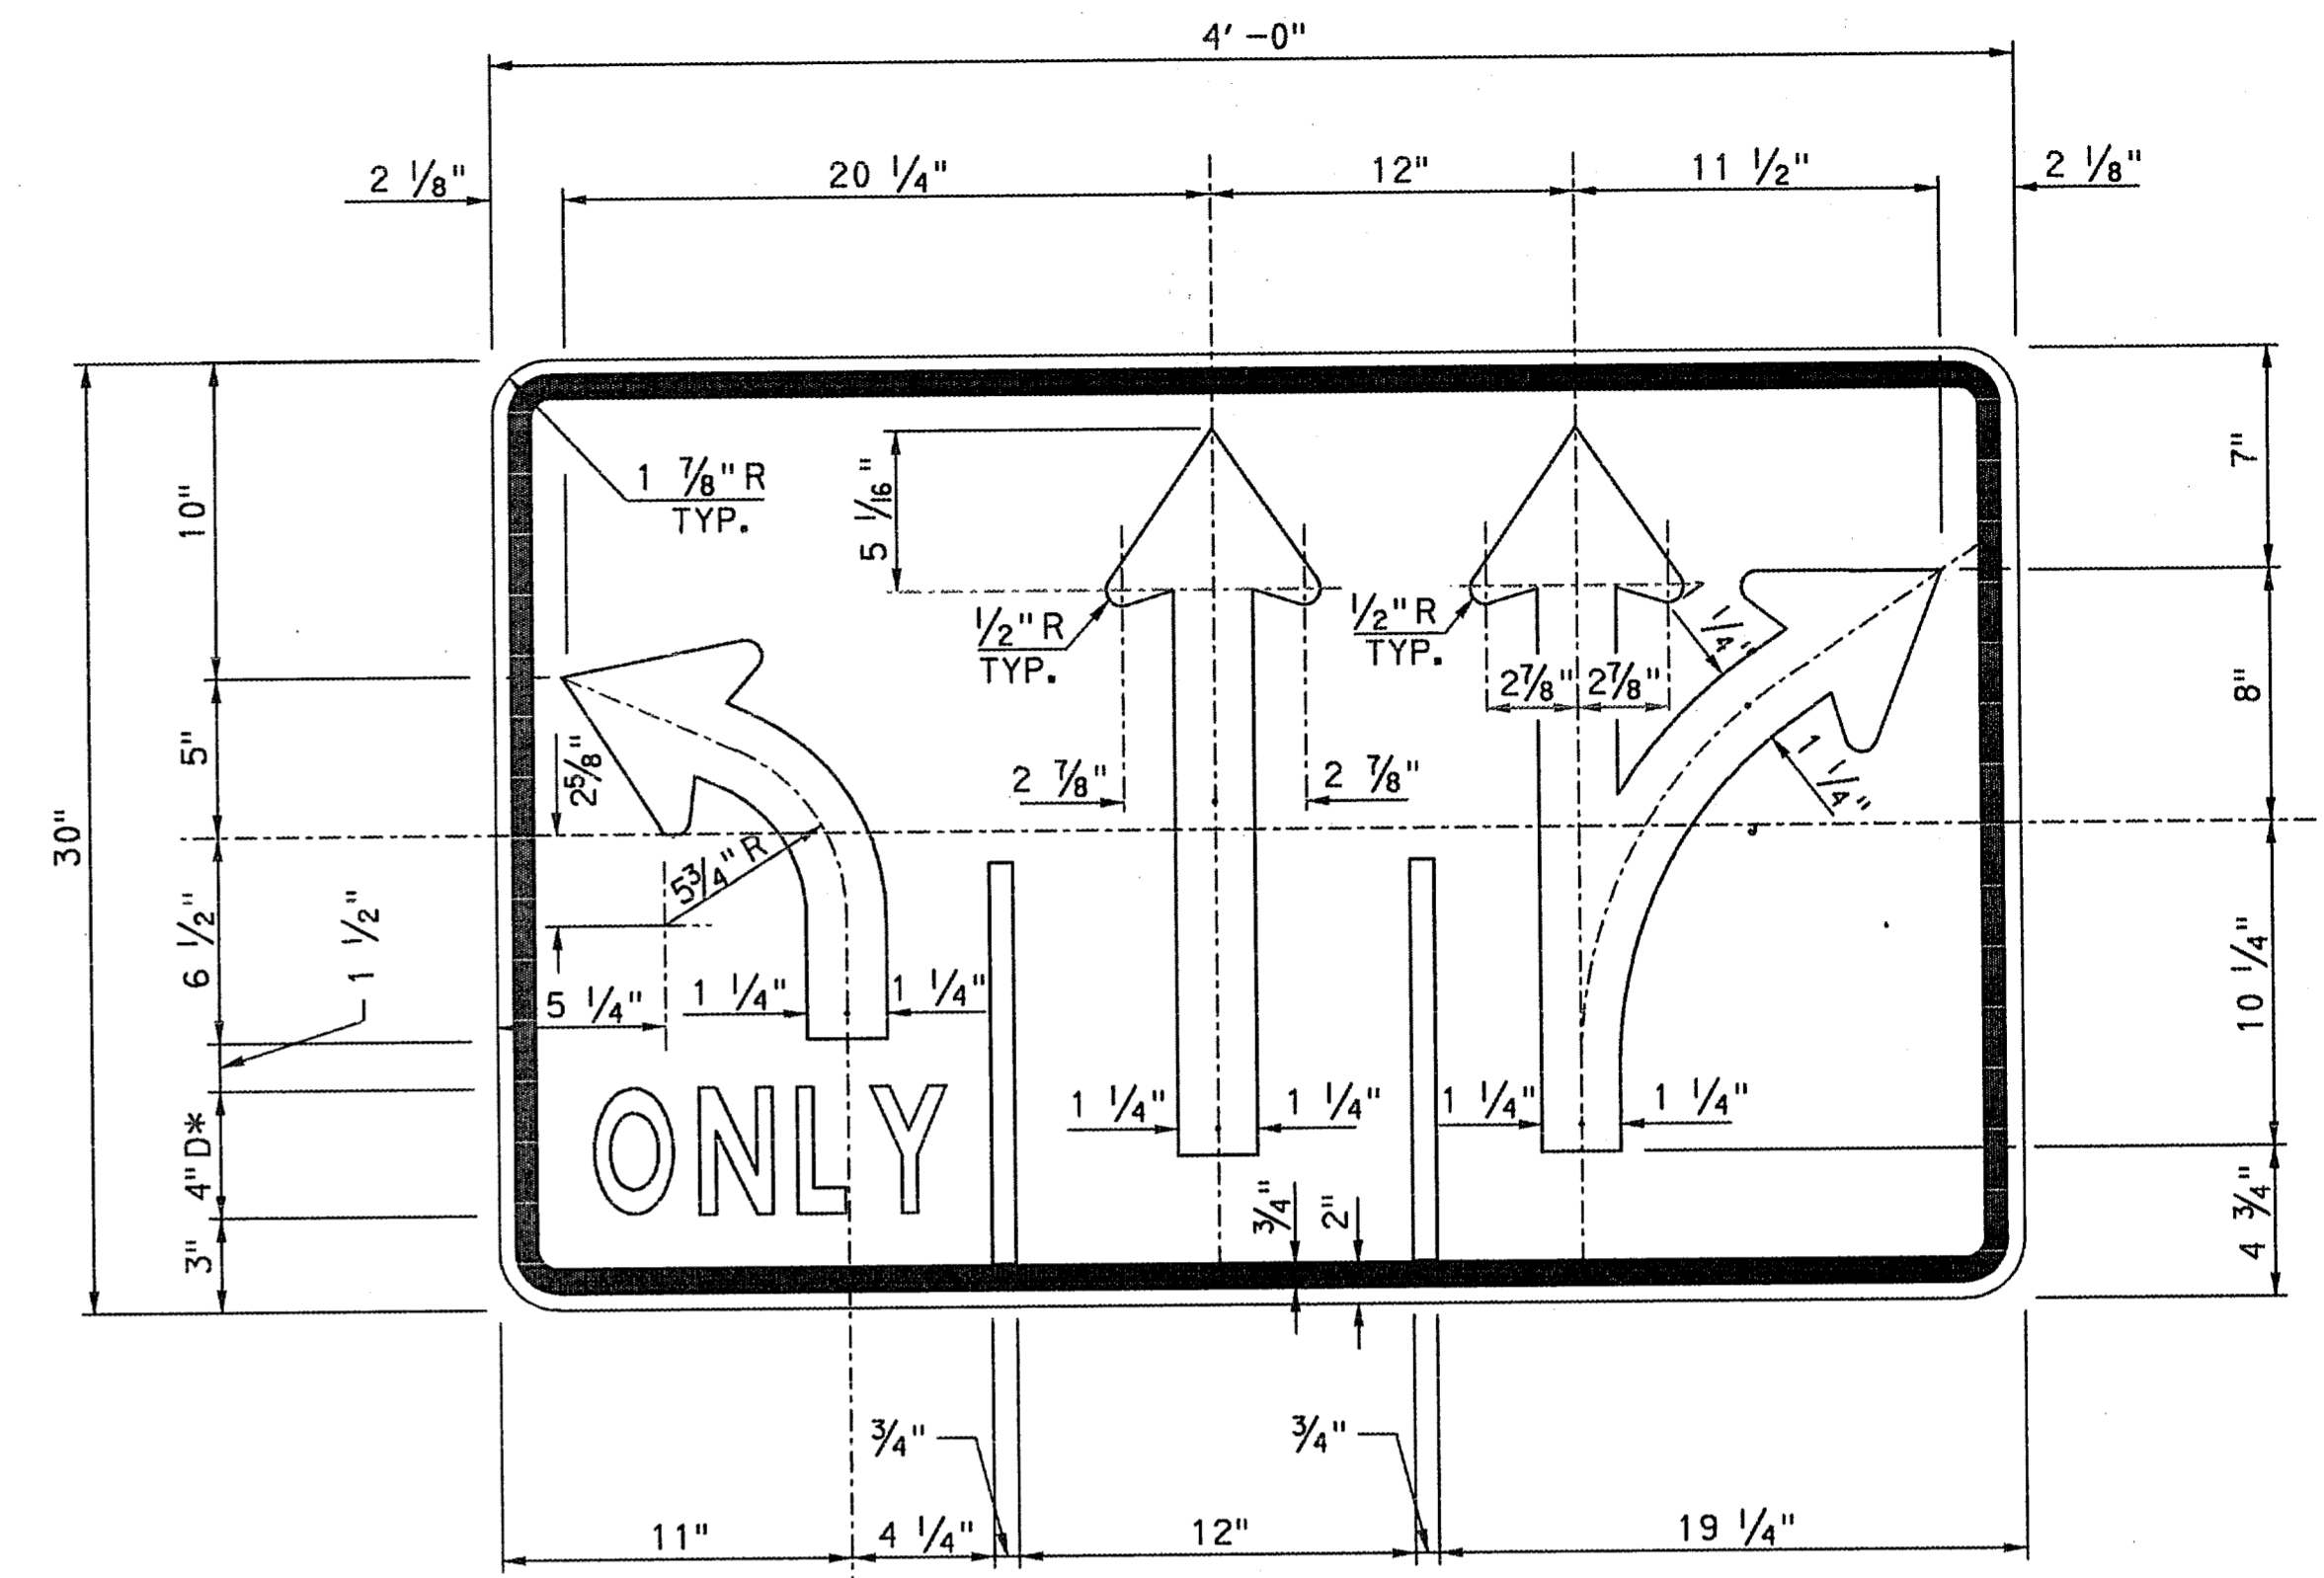


2 AT STA. 35+13

- LEGEND
- BLACK
 - BLACK
 - BLACK
 - WHITE
 - HIGH SPECIFIC INTENSITY (TY C)
 - * • SPACING REDUCED 50%

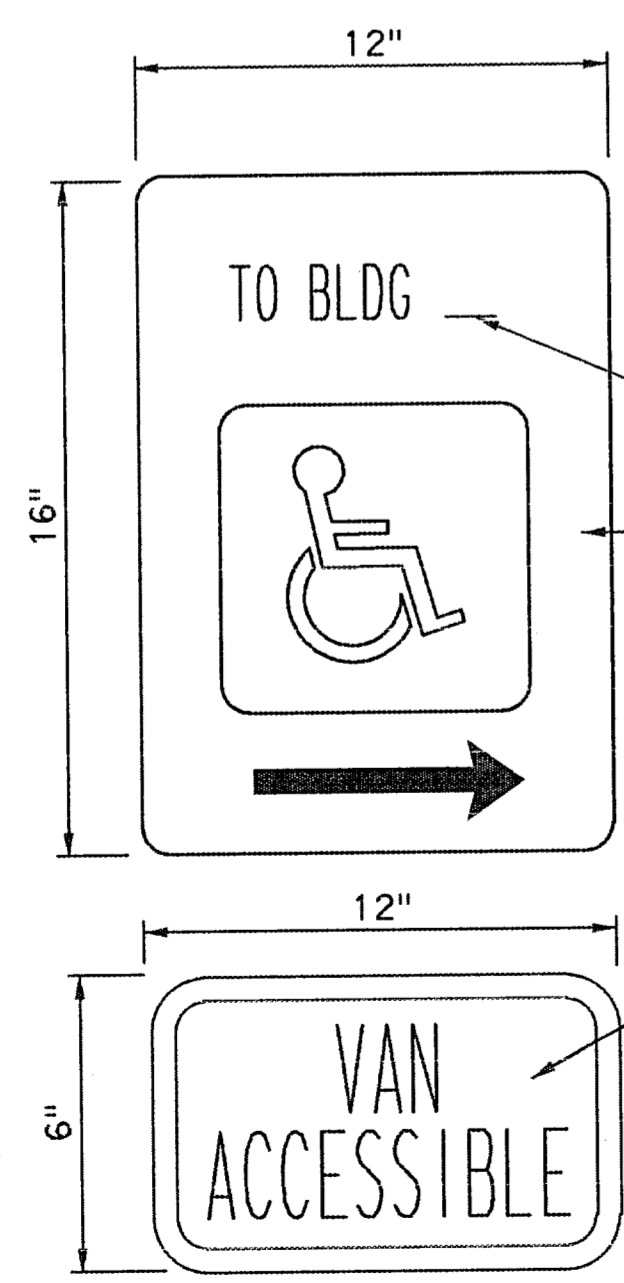

- DESIGNATION BY AUTHORITY, IF ANY
- COLORS:
- LEGEND & BORDER - GREEN
 - BACKGROUND - WHITE
 - SYMBOL - WHITE ON BLUE BACKGROUND


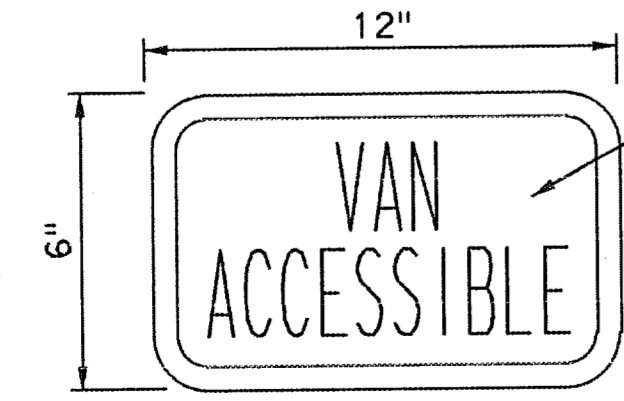


- COLORS:
- LEGEND & BORDER - WHITE
 - BACKGROUND - BLUE

1 EACH AT STA. 2+35

HANDICAPPED SPACE SIGN

N. T. S.
NOTE: CONTRACTOR TO FURNISH AND INSTALL ONE (1)
H. C. SIGN IN PROJECT VICINITY AS SHOWN ON THE PLANS.

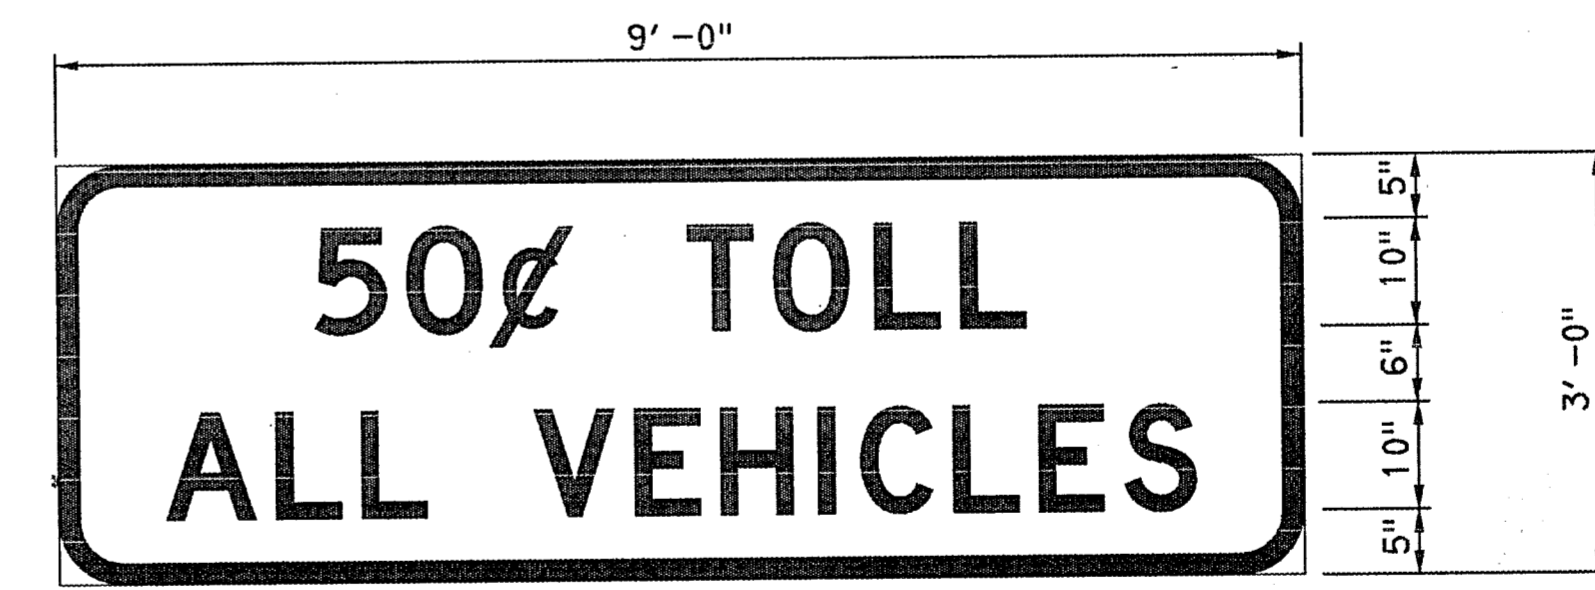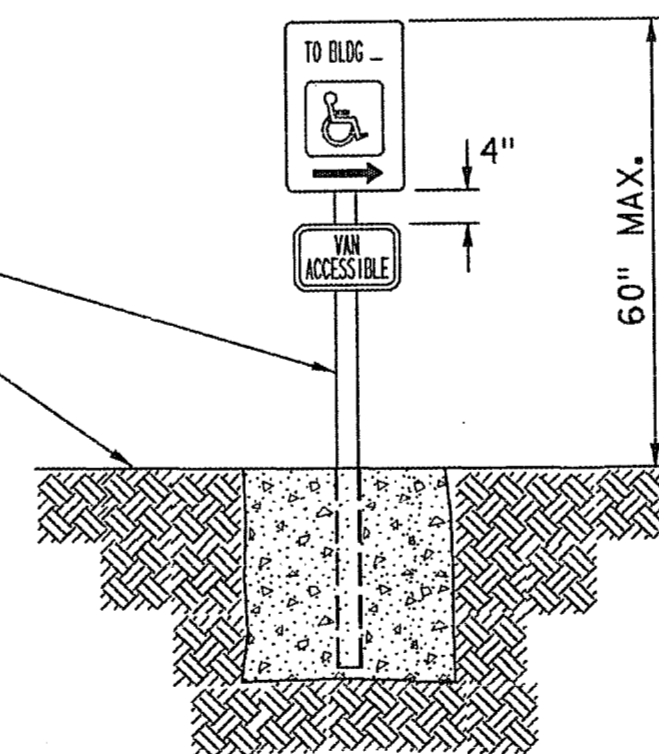

1 AT STA. 1+60
1 AT STA. 35+75

- LEGEND
- WHITE
 - WHITE
 - GREEN
 - HIGH SPECIFIC INTENSITY (TY C)
 - BORDER RADIUS : 6"

THE SEAL APPEARING ON THIS DOCUMENT WAS AUTHORIZED BY RICHARD K. LAIRD, P.E. NO. 59187 ON JANUARY 12, 1999. ALTERATION OF A SEALED DOCUMENT WITHOUT PRIOR NOTIFICATION TO THE RESPONSIBLE ENGINEER IS AN OFFENSE UNDER THE TEXAS ENGINEERING PRACTICE ACT.



FINAL RECORD DRAWING
Date: 12/25/99

No.	REVISION	BY	DATE
NORTH TEXAS TOLLWAY AUTHORITY ADDISON AIRPORT TUNNEL			
SIGN DETAILS			
MATED CONSULTING ENGINEERS, INC. 3800 PETERSON LANE SUITE 225 DALLAS, TEXAS 75240 (972) 233-6700			SECTION XIII
DRAWN: SA	DATE: 5/97	DESIGNED: RKL	DATE: 5/97
CHECKED: SCF	DATE: 5/97	SCALE: NONE	
CONTRACT No. DNT-260 SHEET 12 OF 52			