

REFER TO POLE & LUMINAIRE IDENTIFICATION DETAIL ON SHEET NO. 23 (TYPICAL)

RFI #198
RELOCATING LIGHT POLES IN CONFLICT WITH POWER LINES



GENERAL NOTE 1 (TYP.)

SIGN WITH (2) ALTERNATING RED FLASHING LIGHTS (120 V.) SEE SHEET NO. 25.

KELLER SPRINGS ROAD

MIDWAY ROAD

WEST APPROACH

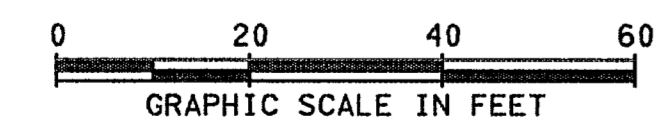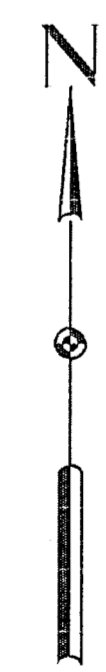

- LEGEND:**
- ROADWAY LIGHTING LUMINAIRE: 400 WATT HIGH PRESSURE SODIUM, TYPE III DISTRIBUTION.
 - ROADWAY LIGHTING LUMINAIRE: 400 WATT HIGH PRESSURE SODIUM, TYPE II DISTRIBUTION.
 - ROADWAY LIGHTING FLOODLIGHTS: NEMA 6X5, 400 WATT HIGH PRESSURE SODIUM, MOUNTED ON POLE TOP BRACKET.
 - WALL-MOUNTED LIGHTING FIXTURE: 150 WATT HIGH PRESSURE SODIUM.
 - W.P. TOGGLE SWITCH.
 - PHOTOCELL.
 - GROUND-MOUNTED LIGHTING UNIT.
 - STRUCTURE-MOUNTED LIGHTING UNIT.
 - GROUND-MOUNTED ROADSIDE SIGN WITH LIGHTS, AS NOTED ON THE PLAN.
 - GROUND-MOUNTED OVERHEAD SIGN WITH LIGHTS, AS NOTED ON THE PLAN.
 - NEW GROUND PULL BOX, SEE SHEET NO. 9.
 - PREVIOUSLY INSTALLED GROUND PULL BOX.
 - PREVIOUSLY INSTALLED EMBEDDED STRUCTURE PULL BOX.
 - PREVIOUSLY INSTALLED CONDUIT.
 - DUCT-CABLE WITH INSULATED AND ONE BARE CONDUCTOR, SIZE AS SHOWN ON THE PLAN.
 - NEW UNDERGROUND CONDUIT, SIZE AS SHOWN ON THE PLAN.
 - CONDUIT AND CONDUCTOR RUNS NUMBER, REFER TO SHEET NO. 4, QUANTITY/ITEMS SUMMARIES.

- GENERAL NOTES**
- COORDINATE DUCT-CABLE AND CONDUIT INSTALLATION WITH CIVIL CONSTRUCTION ELEMENTS—UNDERDRAINS, CONCRETE GUTTERS, FENCES, ETC.

THE SEAL APPEARING ON THIS DOCUMENT WAS AUTHORIZED BY RICHARD J. MILLER, P.E. NO. 42812 ON JANUARY 12, 1999. ALTERATION OF A SEALED DOCUMENT WITHOUT PRIOR NOTIFICATION TO THE RESPONSIBLE ENGINEER IS AN OFFENSE UNDER THE TEXAS ENGINEERING PRACTICE ACT.

FINAL RECORD DRAWING
Date: 12/25/99



REVISED PER RFI #198			
No.	REVISION	BY	DATE
NORTH TEXAS TOLLWAY AUTHORITY ADDISON AIRPORT TUNNEL			
ROADWAY ILLUMINATION LAYOUT STA. 0+00 TO STA. 3+50			
MCE MATED CONSULTING ENGINEERS, INC. 5500 PETERSON LANE SUITE 225 DALLAS, TEXAS 75240 (972) 233-6700			SECTION XIII
DRAWN: SAA	DATE: 5/97	DESIGNED: DR	DATE: 5/97
CHECKED: RJM	DATE: 5/97	SCALE: 1"=20'	
CONTRACT No. DNT-260 SHEET 18 OF 52			