




RI-1
30" X 30"
Letters - White Reflective
Border - White Reflective
Background - Red Reflective

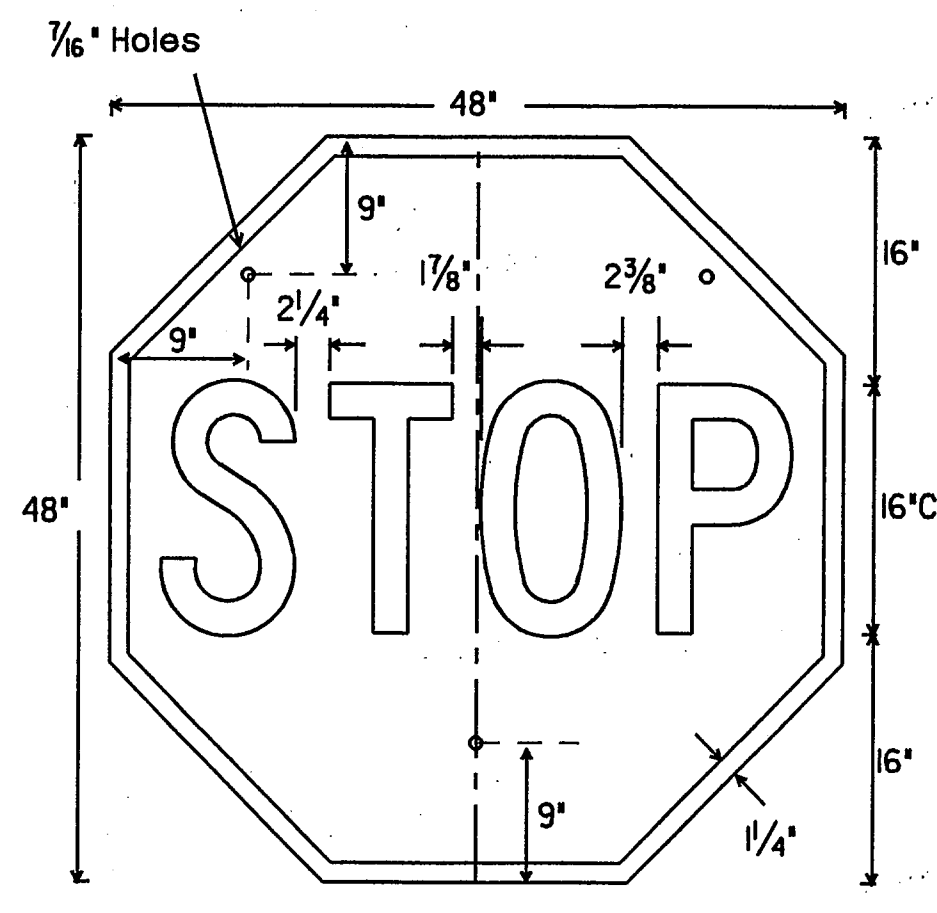


SRI-1
48" X 48"
Letters - White Reflective
Border - White Reflective
Background - Red Reflective

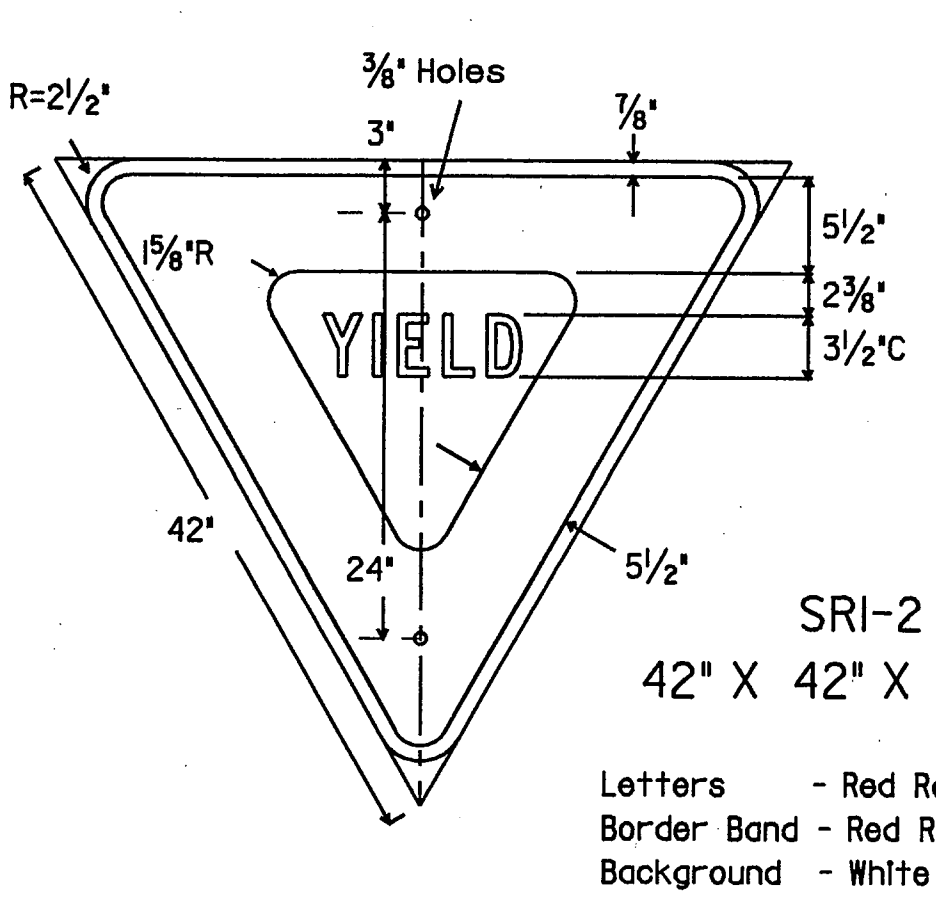


SRI-2
42" X 42" X 42"
Letters - Red Reflective
Border Band - Red Reflective
Background - White Reflective

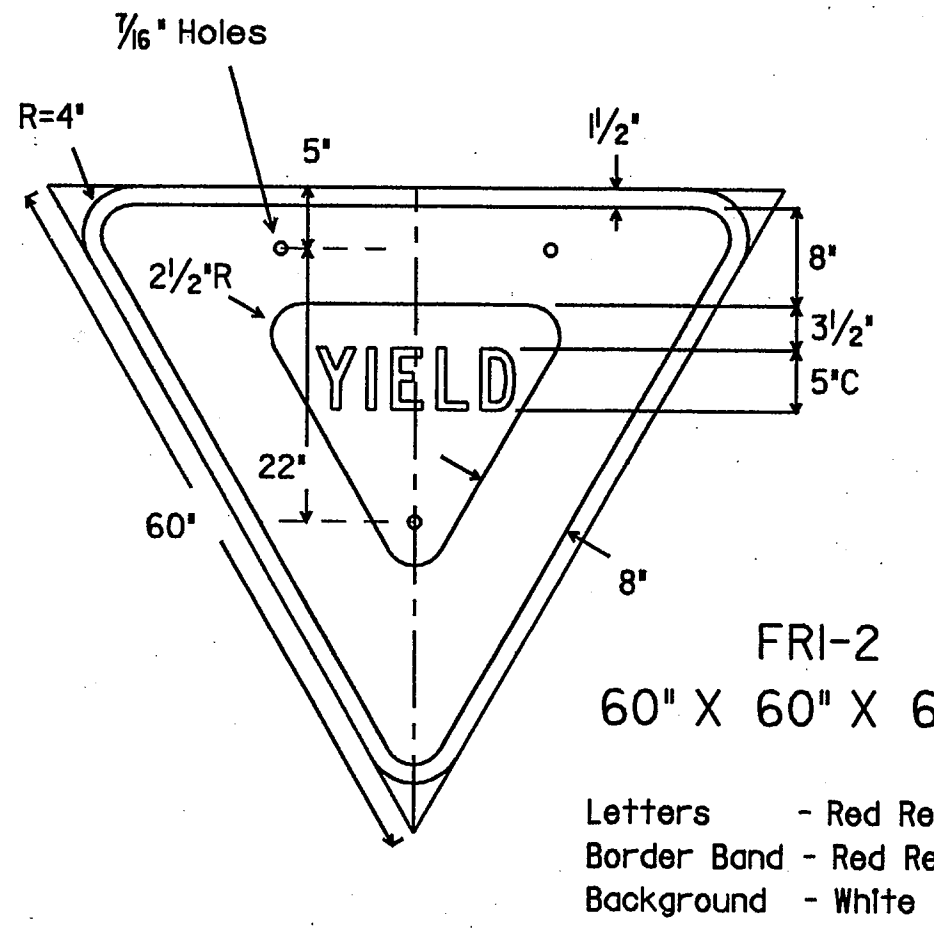


FRI-2
60" X 60" X 60"
Letters - Red Reflective
Border Band - Red Reflective
Background - White Reflective

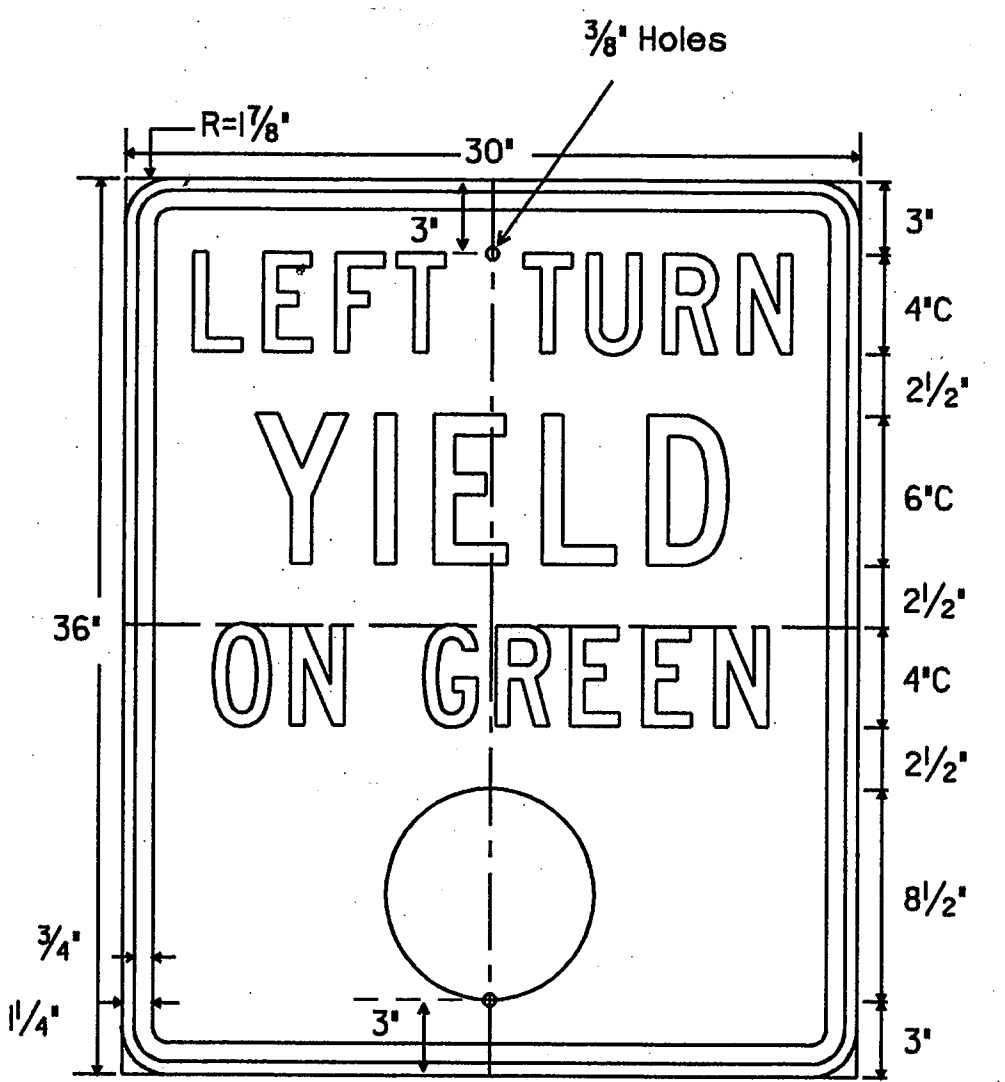


RIO-12
36" X 36"
Letters - Black
Border - Black
Circle - Green Refl.
Background - White Refl.

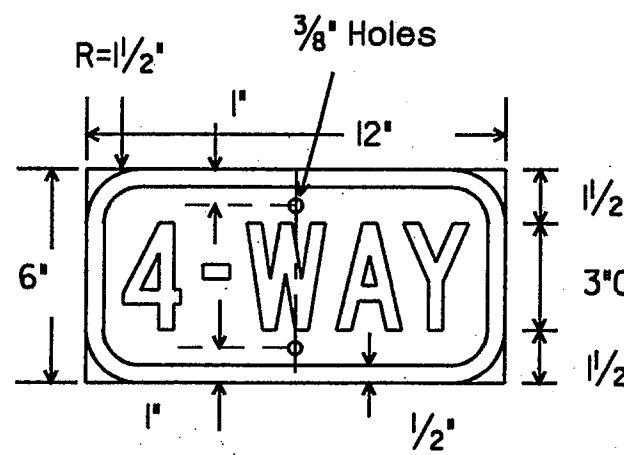


RI-3
12" X 6"
Letters - White Reflective
Border - White Reflective
Background - Red Reflective

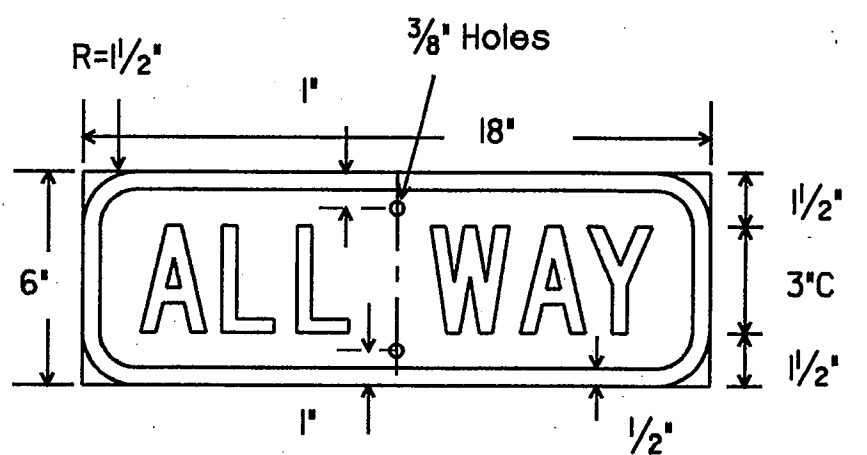


RI-4
18" X 6"
Letters - White Reflective
Border - White Reflective
Background - Red Reflective

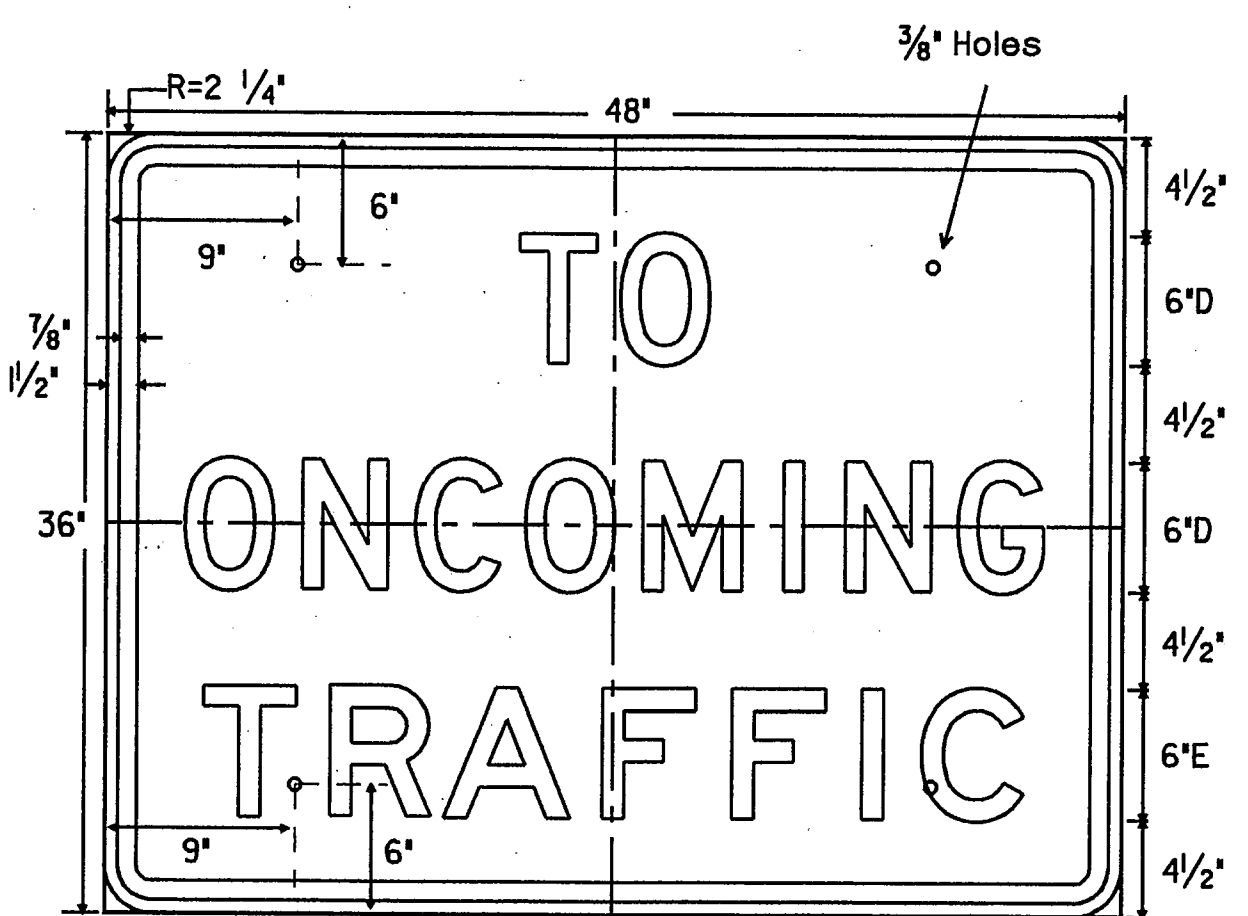


SRI-2b
48" X 36"
Legend - Black
Background - White Refl.

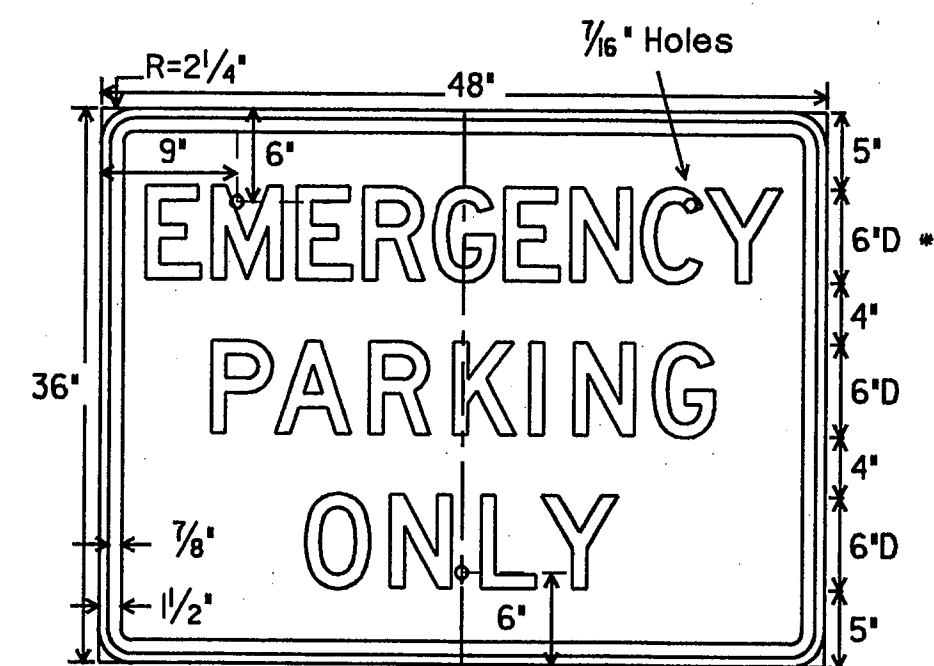


FR8-4
48" X 36"
Legend - Black
Background - White Refl.
* reduce spacing 50%

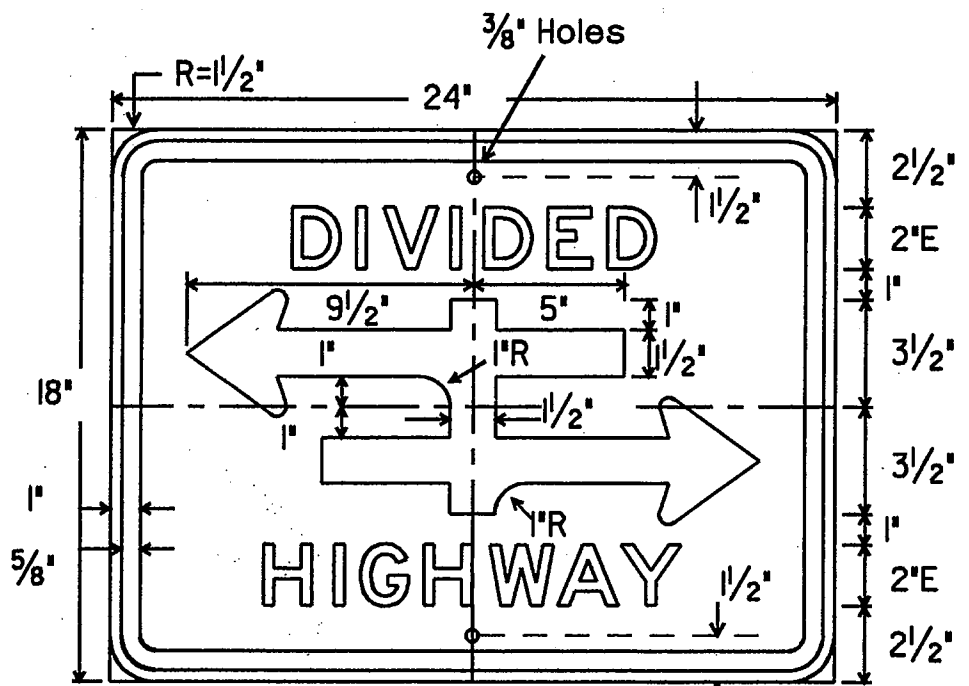


R6-3
24" X 18"
Legend - Black
Background - White Refl.

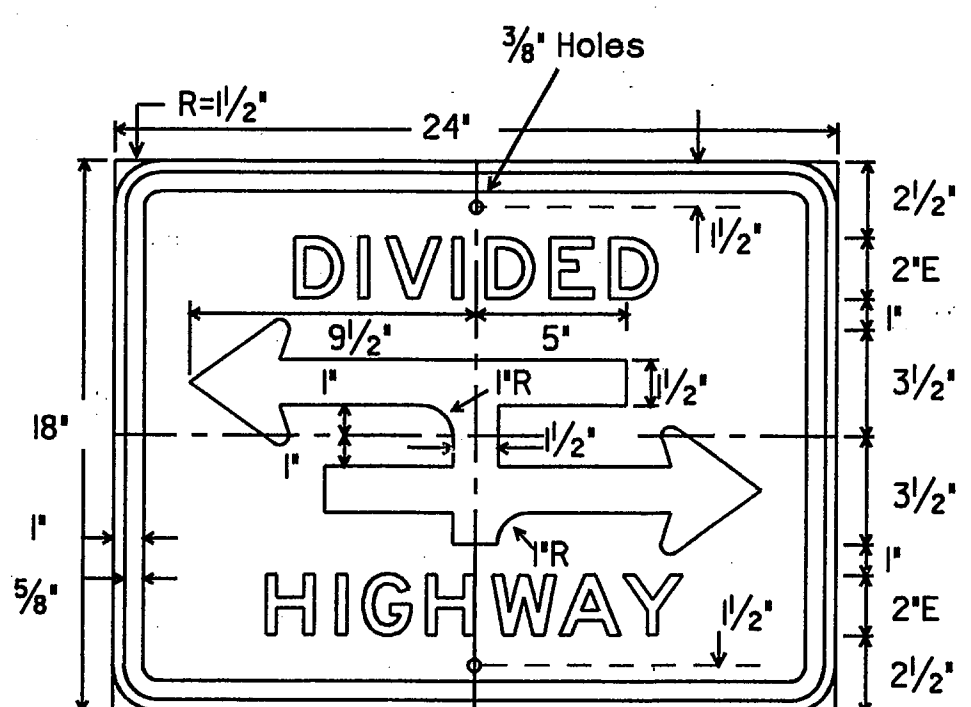

R6-3a
24" X 18"
Legend - Black
Background - White Refl.

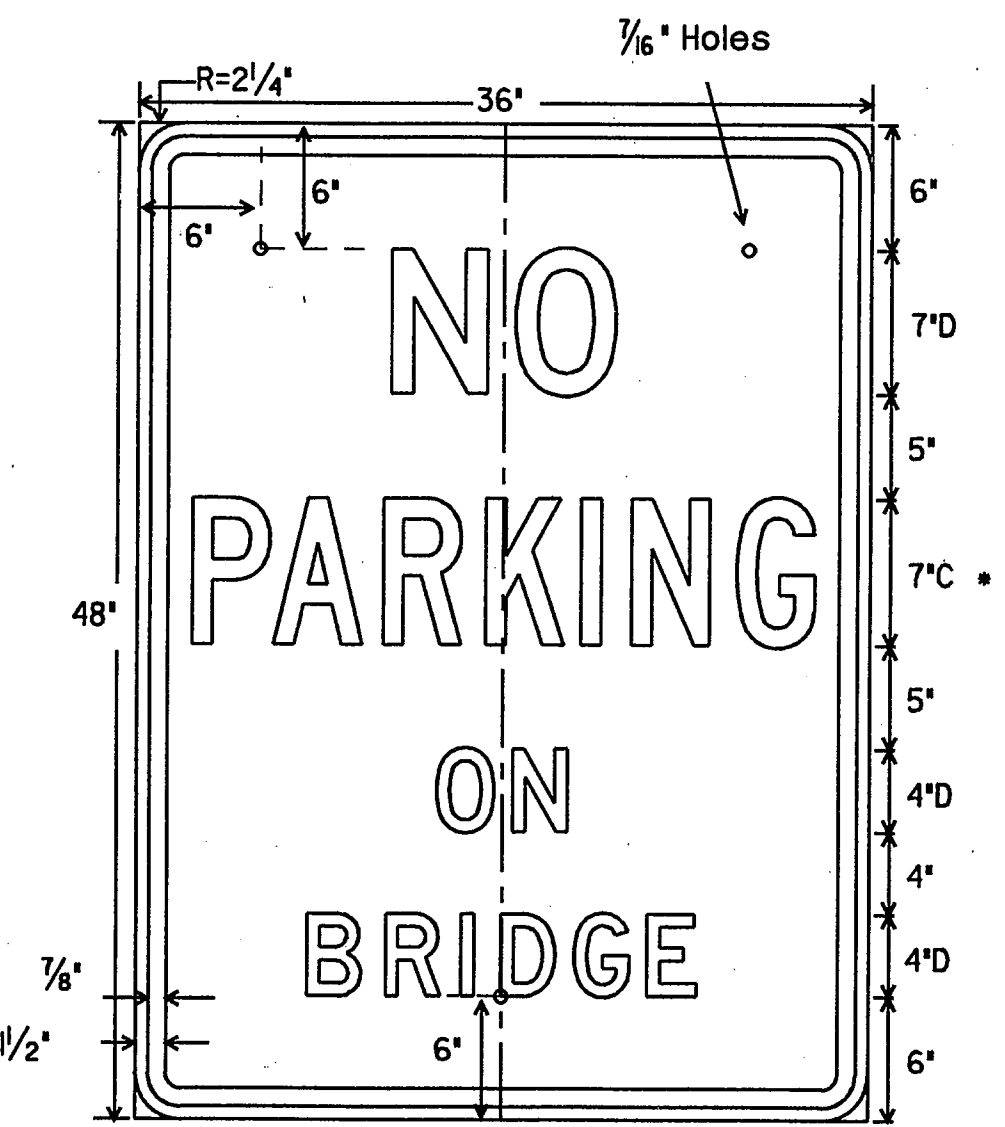

ER8-1T
36" X 48"
Letters - Red Reflective
Border - Red Reflective
Background - White Reflective
* reduce spacing 50%

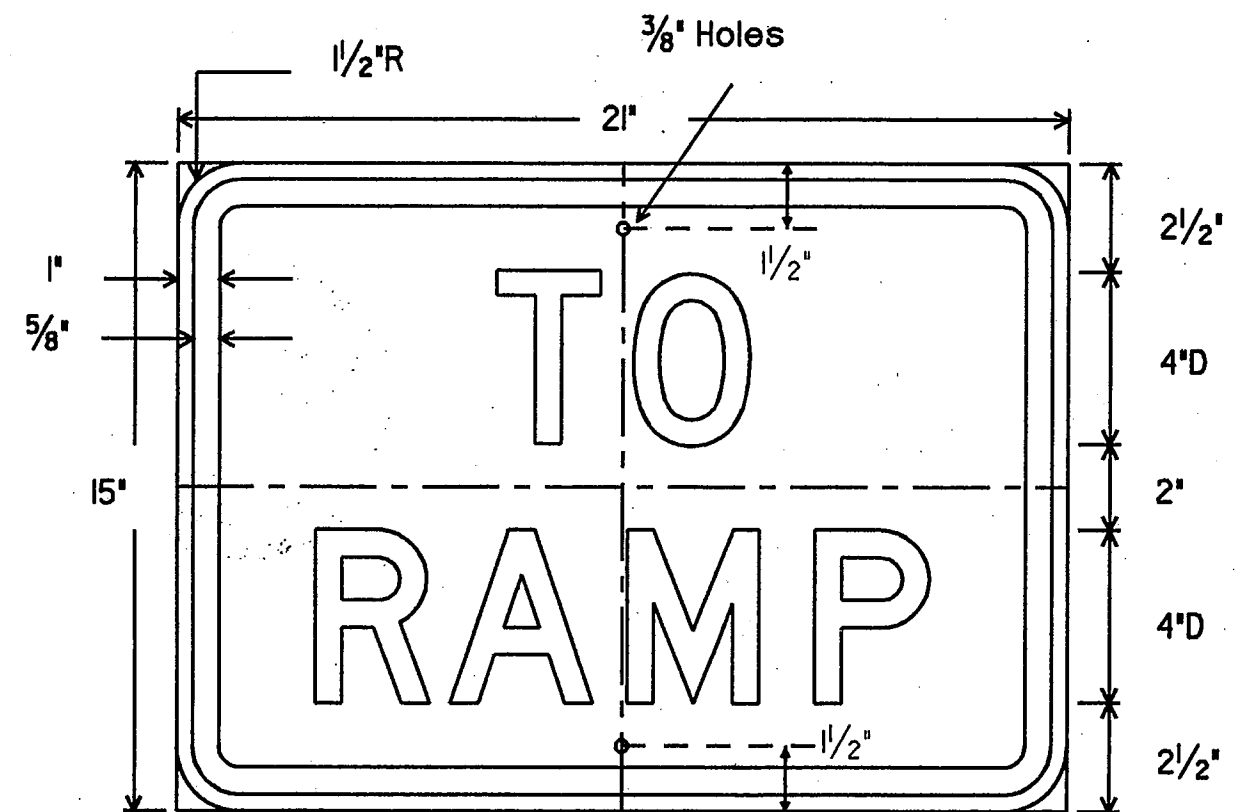


RI-2a
21" X 15"
Legend - Black
Background - White Refl.

SPECIFICATION REFERENCE TABLE	
MATERIALS AND TESTS DIVISION SPECIFICATIONS	
ALUMINUM SIGN BLANKS	D-9-710 Δ
REFLECTIVE SHEETING, TYPE A (ENGINEER GRADE) (FOR BLACK AND WHITE SIGNS ON THIS SHEET)	D-9-8300
REFLECTIVE SHEETING, TYPE C (HIGH SPECIFIC INTENSITY) (FOR RED SERIES SIGNS ON THIS SHEET)	D-9-8300
VINYL NON-REFLECTIVE DECAL SHEETING	D-9-8320

GENERAL NOTES:
The alphabets and lateral spacing between letters and numerals shall conform with the Texas 'Manual on Uniform Traffic Control Devices for Streets and Highways', latest edition, and any approved changes thereto. Lateral spacing of text shall provide a balanced appearance. All materials shall conform to Department Specifications.
Legend (except where noted), shall be applied by screening process of black and/or transparent colored ink, cut-out black vinyl non-reflective decal sheeting, and/or reflective sheeting or combination thereof. Legend on RI-1, SRI-1, RI-3 and RI-4 shall be applied by reverse screening process with transparent colored ink or cut-out white reflective sheeting applied to colored background or combination thereof. Background shall be reflective sheeting.
Sign blanks shall be one piece 0.080 inch thick sheet aluminum alloy Δ (Type A), unless otherwise noted elsewhere in the plans.

LEVELS DISPLAYED
 1 2 3 4 5 6 7 8 9 10 11 12 13 14 15 16
 DATE: _____
 FILE: _____
 ACC: d58mpic/usr/d580504
 CK: CW
 DW: DN
 CK: MT

FINAL RECORD
DRAWING
Date: 12/25/99

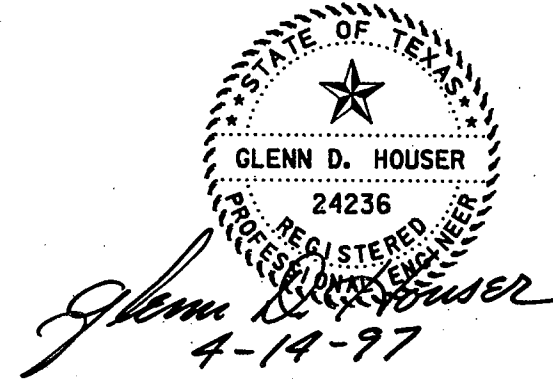

ISSUE DATE: 11-26-96

STANDARD PLANS
TEXAS DEPARTMENT OF TRANSPORTATION
Traffic Operations Division

REGULATORY SIGNS

R(1)-95 (MOD.)

ORIG. DRAW. DATE: FEB. 1976	REV. NO.:	STATE DISTRICT:	FEDERAL REGION:	FEDERAL AID PROJECT:	SHEET NO.:
			6		37
COUNTY:		CONTROL SECTION:		JOB HIGHWAY:	