

HANGAR ADDITION PLANS FOR: EHOAA - EXECUTIVE HANGAR OWNERS ASSOCIATION OF ADDISON


ADDISON AIRPORT
ADDISON, TEXAS

AUGUST 2008

PW# 2008-07

SHEET INDEX

	COVERSHEET
	PLAT
C1	SITE DIMENSIONAL CONTROL PLAN
C2	DEMOLITION PLAN
C3	GRADING AND DRAINAGE PLAN
C4	OFF-SITE DRAINAGE AREA MAP
C5	STORM DRAIN PLAN
C6	STORM DRAIN PROFILES
C7	STORM DRAIN PROFILES
C8	STORM DRAIN DETAILS
C8A	STORM DRAIN DETAILS
C9	EROSION CONTROL PLAN
C9A	EROSION CONTROL DETAILS
C10	UTILITY SERVICES PLAN

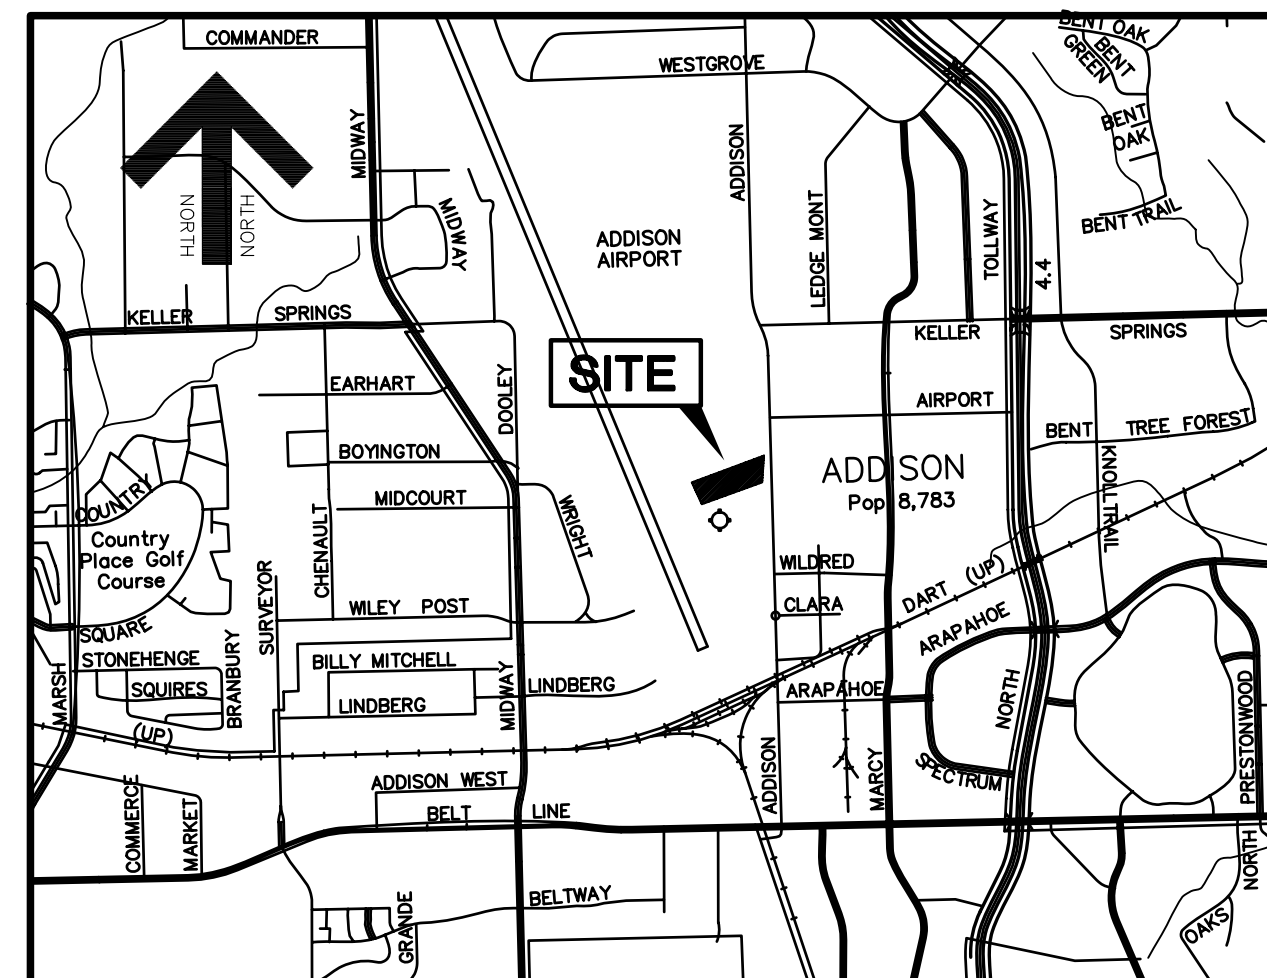

LOCATION MAP

SCALE: 1"=2000'

PREPARED FOR:
MSF PROPERTIES
TWO LEGACY TOWN CENTER
6900 N. DALLAS PARKWAY, SUITE 730
PLANO, TEXAS 75024
PHONE: (972) 403-0909
CONTACT: RICHARD FRENCH

"AS-BUILT"

THIS AS-BUILT DRAWING IS BASED ON INFORMATION OBTAINED FROM BUILDING CONTRACTORS DURING CONSTRUCTION AS PROVIDED TO JDJR ENGINEERS & CONSULTANTS, INC. JDJR ENGINEERS & CONSULTANTS, INC. DOES NOT GUARANTEE THE ACCURACY OR COMPLETENESS OF THESE RECORDS.

JDJR	ENGINEERS AND CONSULTANTS, INC.	
	ENGINEERS • SURVEYORS • LAND PLANNERS	
2500 Texas Drive Suite 100 Irving, Texas 75062		
Tel 972-252-5357 (JDJR) Fax 972-252-8958		