

REMOVE ALL EXISTING IMPROVEMENTS (BUILDINGS, PAVING WALKS ETC.) WITHIN AREA INDICATED BY HATCHING. COORDINATE REMOVAL OF EXISTING UTILITY SERVICES WITH UTILITY COMPANIES (REFER TO UTILITY PLAN ALSO)


**"AS-BUILT"**  
THIS AS-BUILT DRAWING IS BASED ON INFORMATION OBTAINED FROM BUILDING CONTRACTORS DURING CONSTRUCTION AS PROVIDED TO J.D.R. ENGINEERS & CONSULTANTS, INC. J.D.R. ENGINEERS & CONSULTANTS, INC. DOES NOT GUARANTEE THE ACCURACY OR COMPLETENESS OF THESE RECORDS.

**NOTES:**

1. DEMOLITION CONTRACTOR TO BE FAMILIAR WITH ALL PROPOSED CONSTRUCTION PLANS BEFORE ANY SITE DEMOLITION COMMENCES.
2. COORDINATE ALL SITE DEMOLITION WITH THE ARCHITECT AND ALL UTILITY CONTRACTORS.
3. DEMOLITION CONTRACTOR TO LOCATE ALL UNDERGROUND UTILITIES PRIOR TO ANY DEMOLITION WORK. CONTACT UTILITY COMPANIES AT LEAST 2 WORKING DAYS PRIOR TO ANY DEMOLITION WORK.
4. CONTACT THE TOWN OF ADDISON FINANCE DEPARTMENT AT 972-450-1080 TO DISCONNECT WATER SERVICE PRIOR TO DEMOLITION OF THE ONMIFLIGHT BUILDING.

 INDICATES EXISTING IMPROVEMENTS TO BE REMOVED

REVISIONS:	
6/04/08	CITY COMMENTS
7/25/08	CITY COMMENTS
8/01/08	CITY COMMENTS
8/05/08	CITY COMMENTS
9/02/09	AS BUILT

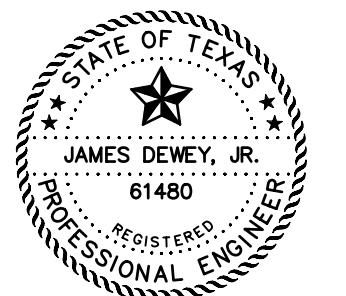

SHEET TITLE:  
**DEMOLITION PLAN**  
HANGER ADDITION PLANS FOR EXECUTIVE HANGER OWNERS ASSOCIATION OF ADDISON AIRPORT  
ADDISON, TEXAS

PREPARED BY:  
**JDJR ENGINEERS AND CONSULTANTS**  
ENGINEERS • SURVEYORS • LAND PLANNERS  
2500 Texas Drive Suite 100 Irving, Texas 75062  
Tel 972-252-5357 Fax 972-252-8958

DATE: APR. 8, 2008 DRAWN BY: SAS SHEET NO.  
SCALE: 1" = 30' CHECKED BY: JDJR **C2** OF 10