


DRAINAGE DATA						
AREA NO.	ACRES	C	T _C MIN	I ₂ IN/HR	Q ₂ CFS	
A1	3.42	1.0	10	5.04	17.24	
A2	0.39	1.0	10	5.04	1.97	
A3	3.33	1.0	10	5.04	16.78	
A4	0.71	1.0	10	5.04	3.58	
A5	2.62	1.0	10	5.04	13.20	
A6	0.80	1.0	10	5.04	4.03	
B	0.29	1.0	10	5.04	1.46	
C1	2.85	1.0	10	5.04	14.36	
C2	0.35	1.0	10	5.04	1.76	

REVISIONS:	
9/02/09	AS BUILT

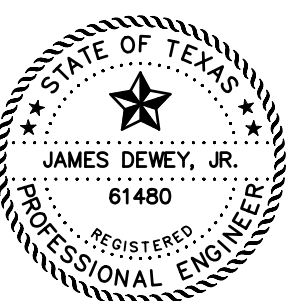

"AS-BUILT"
 THIS AS-BUILT DRAWING IS BASED ON INFORMATION OBTAINED FROM BUILDING CONTRACTORS DURING CONSTRUCTION AS PROVIDED TO JDJR ENGINEERS & CONSULTANTS, INC.
 JDJR ENGINEERS & CONSULTANTS, INC. DOES NOT GUARANTEE THE ACCURACY OR COMPLETENESS OF THESE RECORDS.

SHEET TITLE:
OFF-SITE DRAINAGE AREA MAP
 HANGER ADDITION PLANS FOR
 EXECUTIVE HANGER OWNERS ASSOCIATION OF ADDISON
 ADDISON AIRPORT
 ADDISON, TEXAS

PREPARED BY:
JDJR ENGINEERS AND CONSULTANTS
 ENGINEERS • SURVEYORS • LAND PLANNERS
 2500 Texas Drive Suite 100 Irving, Texas 75062
 Tel 972-252-5357 Fax 972-252-8958

DATE: APR. 8, 2008 DRAWN BY: SAS SHEET NO.
 SCALE: 1" = 100' CHECKED BY: JDJR **C4** OF **10**