


REVISIONS:	
6/04/08	CITY COMMENTS
9/02/09	AS BUILT

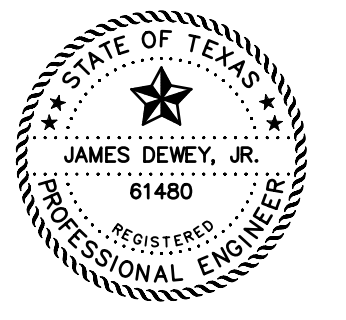

SHEET TITLE:
STORM DRAIN PROFILES
 HANGER ADDITION PLANS FOR
 EXECUTIVE HANGAR OWNERS ASSOCIATION OF ADDISON
 ADDISON AIRPORT
 ADDISON, TEXAS

PREPARED BY:
JDJR ENGINEERS AND CONSULTANTS
 ENGINEERS • SURVEYORS • LAND PLANNERS
 2500 Texas Drive Suite 100 Irving, Texas 75062
 Tel 972-252-6357 Fax 972-252-8958

"AS-BUILT"
 THIS AS-BUILT DRAWING IS BASED ON INFORMATION OBTAINED FROM BUILDING CONTRACTORS DURING CONSTRUCTION AS PROVIDED TO JDJR ENGINEERS & CONSULTANTS, INC.
 JDJR ENGINEERS & CONSULTANTS, INC. DOES NOT GUARANTEE THE ACCURACY OR COMPLETENESS OF THESE RECORDS.

DATE: APR. 8, 2008 DRAWN BY: SAS SHEET NO.
 SCALE: 1"=3'H, 1"=5'V CHECKED BY: JDJR **C6** OF 10